


T. 34 S., R. 5 W., W.M.

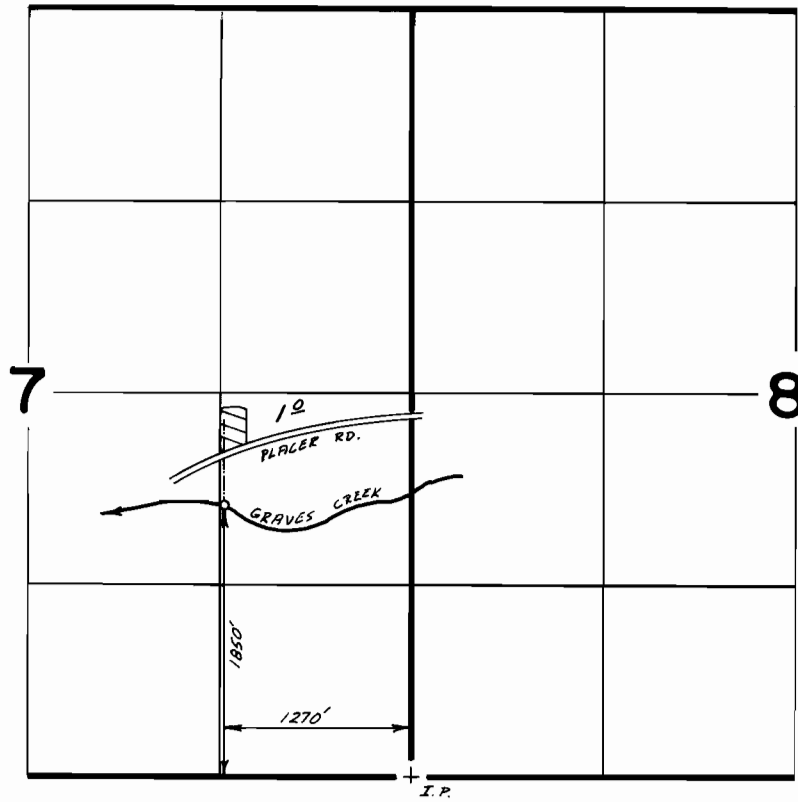

Scale 1"=1320'

FINAL PROOF SURVEY
UNDER

Application No. 54998 Permit No. 41211.....
IN NAME OF

.....JOE R. BEAUDRO.....

Surveyed Aug. 13, 1986, by B.S. JAMES.....