P-41214 57510
P-41215 57511

T. 9 & 10 S. R. 20 E. W. M.

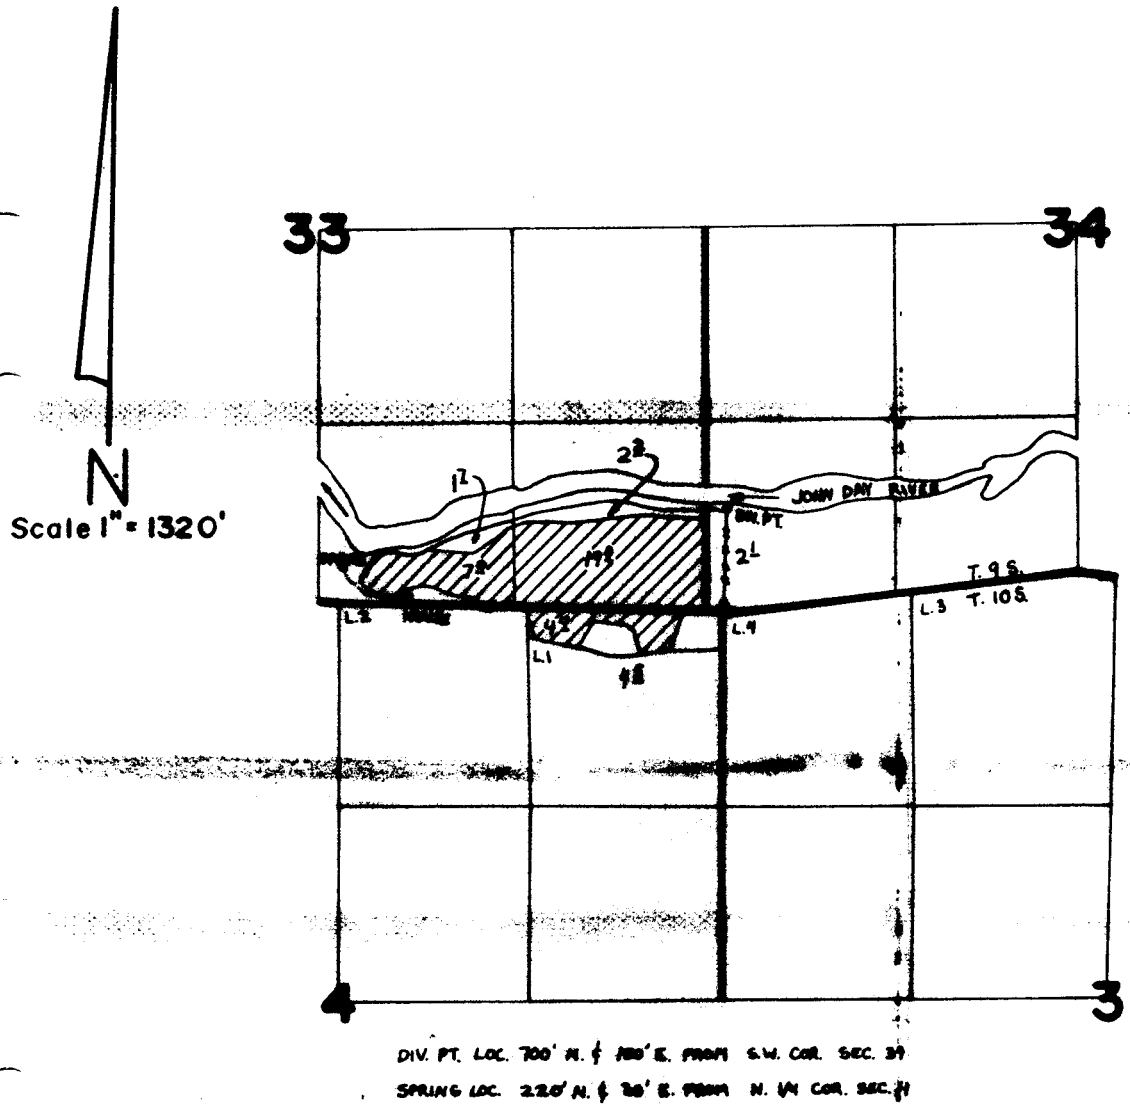

DIV. PT. LOC. 700' N. & 200' E. FROM S.W. COR. SEC. 34
SPRING LOC. 220' N. & 30' E. FROM N. W. COR. SEC. 4

FINAL PROOF SURVEY
UNDER

Application No. 55001 55002 Permit No. 41214 41215

IN NAME OF

KENNETH A. BOND

Surveyed April 21, 1986, by V. Church