


T.29 S., R.6 W., W.M.

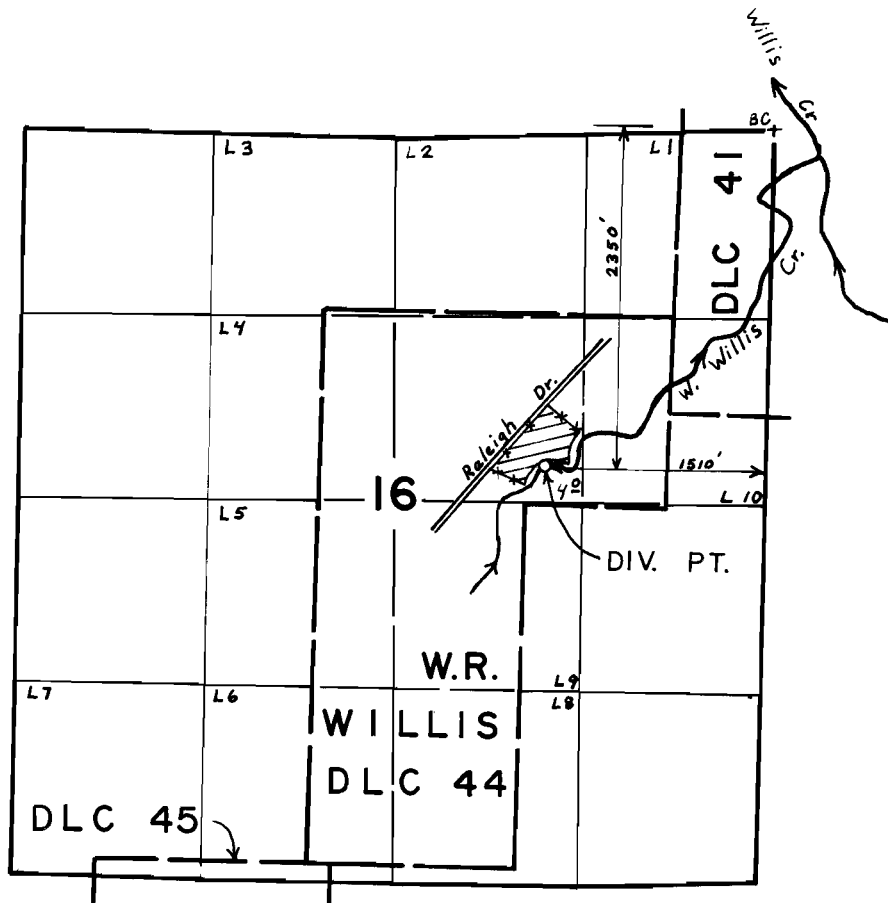

SCALE: 4" = 1 mile

FINAL PROOF SURVEY
UNDER

Application No. 55039. Permit No. 41284.....
IN NAME OF

THOMAS H. & LOIS HAIRE

Surveyed JAN. 26 1984, by *L. E. Cashion*