


T.12S.,R.6W.,W.M.

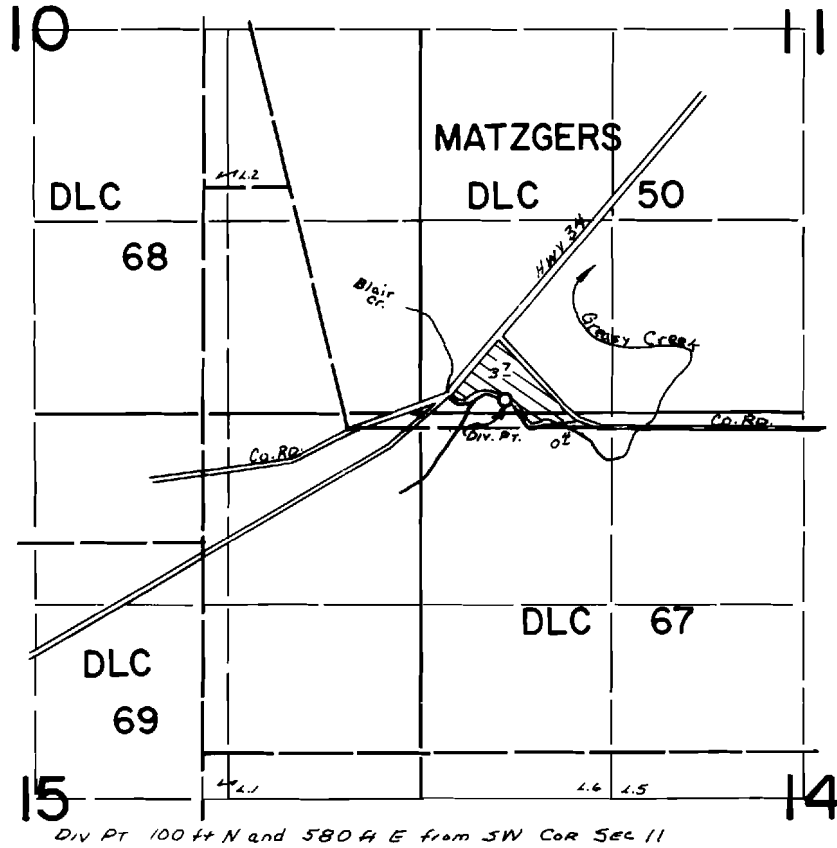

**FINAL PROOF SURVEY**  
UNDER

Application No. ...55069... Permit No. ....41295.....  
IN NAME OF

.....**ROBERT FENNER**.....

Surveyed Sept...10... 19.82., by L.M.TOLL.....