


T. 1 N., R. 46 E. W.M.

SCALE: 1"=1320'

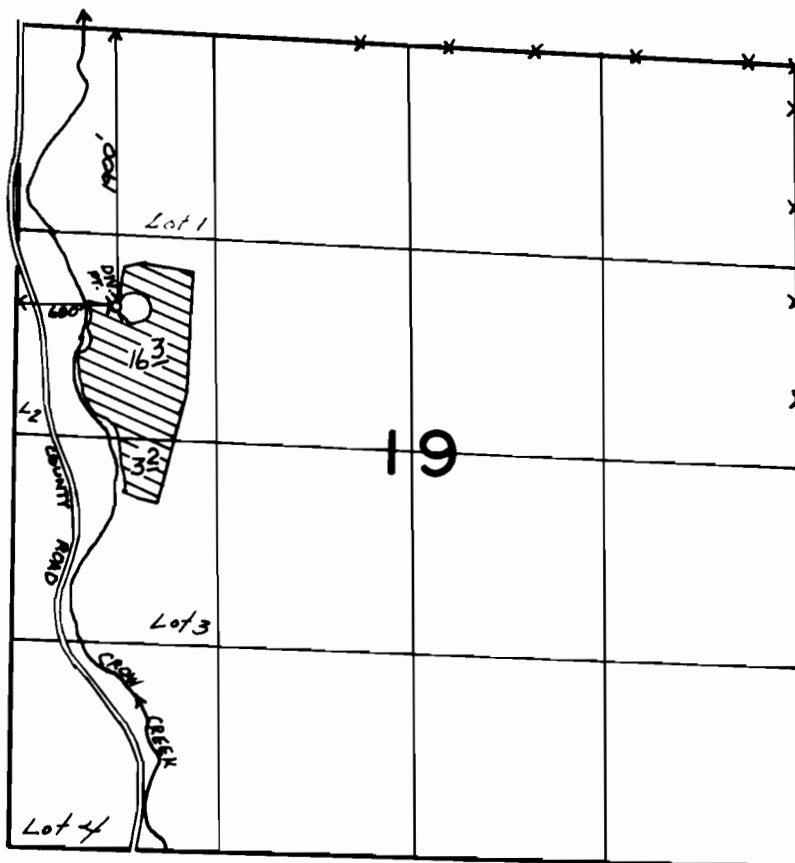

FINAL PROOF SURVEY
UNDER

Application No. 55364 Permit No. 41500
IN NAME OF

JOHN STEIN JR.

Surveyed Aug. 28... 1985, by V.L. CHURCH.....