


T.17S.,R.3E.,W.M.

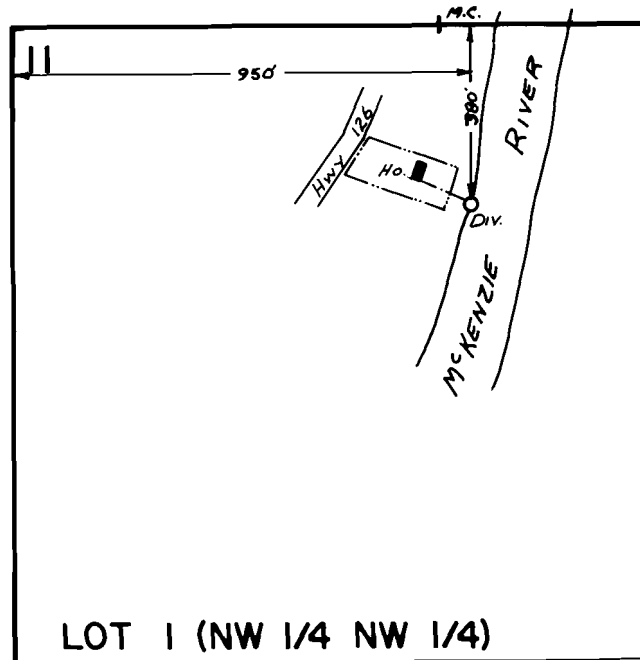

LOT 1 (NW 1/4 NW 1/4)

SECTION 11

SCALE: 1"=400'

FINAL PROOF SURVEY
UNDER

Application No. 55583.. Permit No. 41507.....
IN NAME OF

JAMES J. & JULIANA GRAVLEY

Surveyed Aug. 20. 1981., by S.C. BROWN.....