


# T.17S.,R.3W.,W.M.

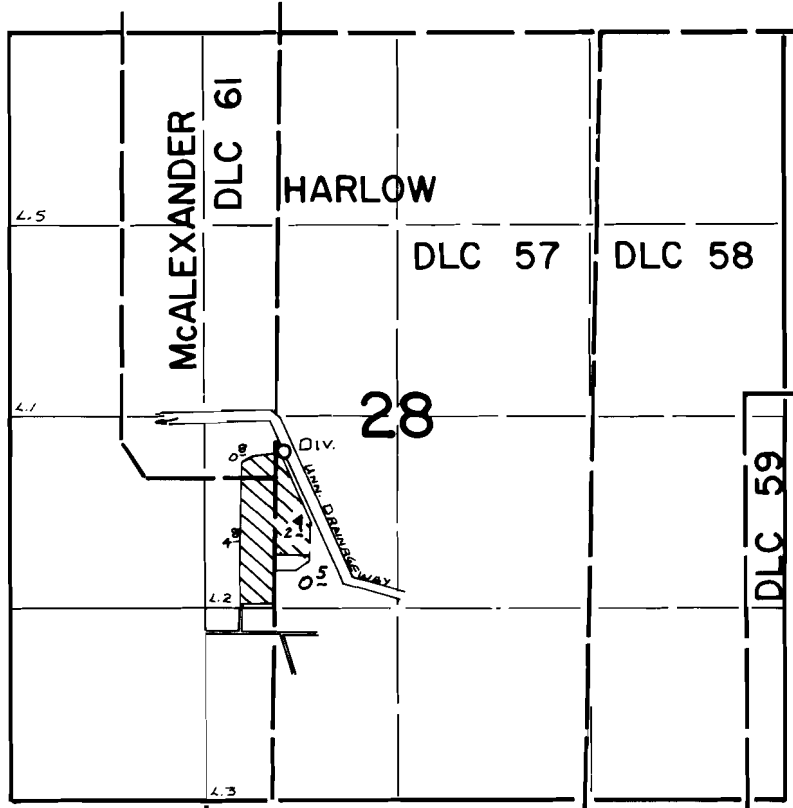

DIV LOC: 180 ft N AND 60 ft E FROM SE COR MCALEXANDER DLC 61

## FINAL PROOF SURVEY UNDER

Application No. 55388... Permit No. 41534.....  
IN NAME OF

BERT DENHAM

Surveyed Aug. 19... 19.81., by S. C. BROWN.....