


# T. 5 S., R. 3 W., WM.

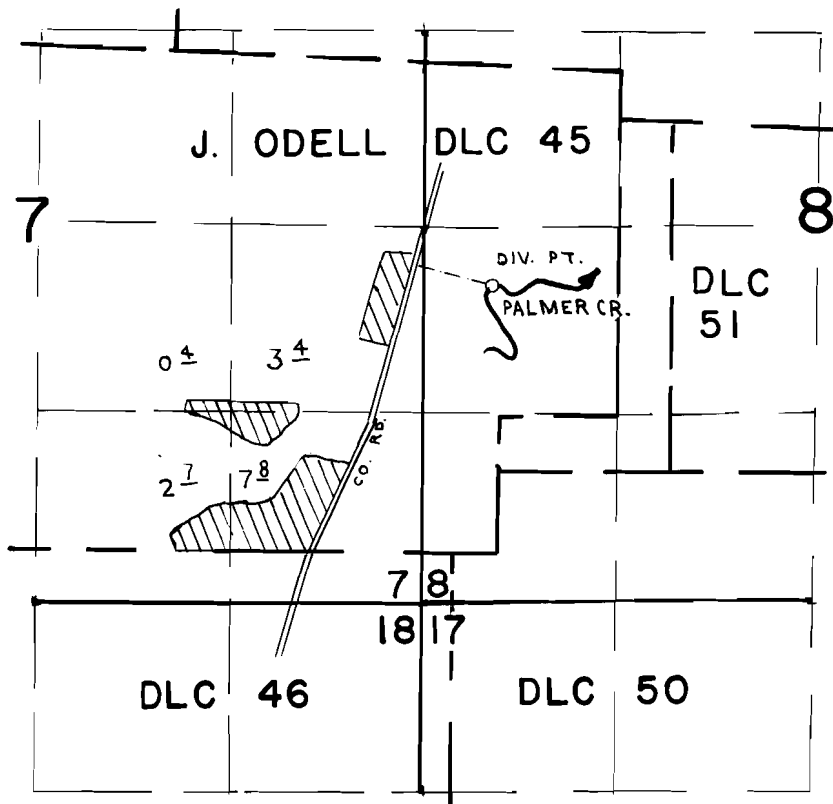

DIV. PT. LOC. 2200' N. & 450' E. OF SW COR. SEC. 8

## FINAL PROOF SURVEY UNDER

Application No. 55391 Permit No. 41535

IN NAME OF

Michael S. Carr

Surveyed APR 26, 1984, by P. PAGTER