


T.15S.,R.5W.,W.M.

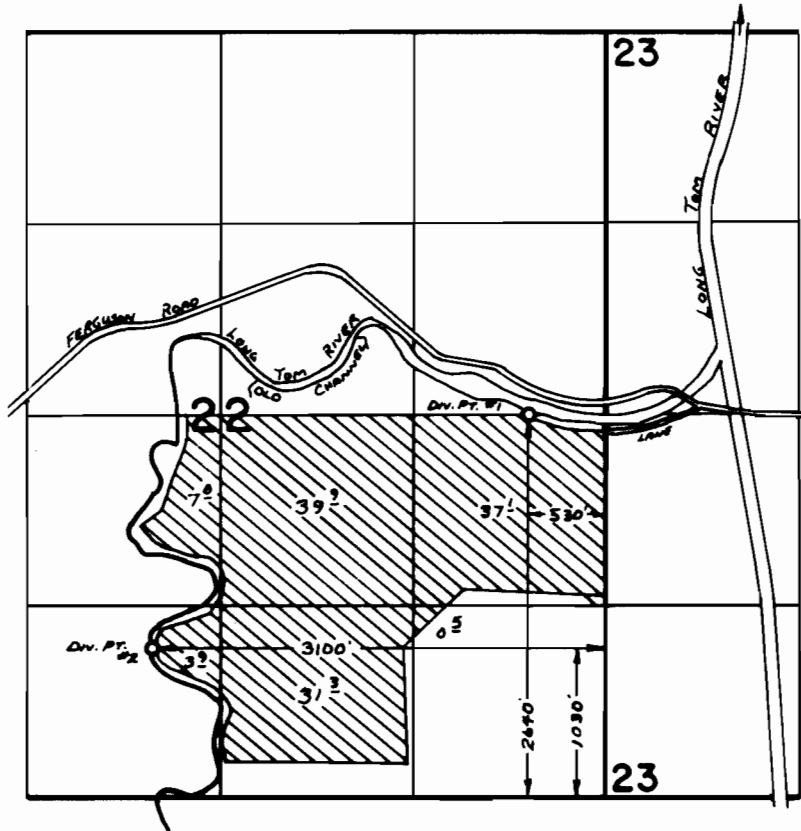

**FINAL PROOF SURVEY**  
UNDER

Application No. .55086.. Permit No. ...4.1582.....  
IN NAME OF

.....JUPE HOLM.....

Surveyed June 17, 1982, by L. M. TOLL.....