


# T. 40 S., R. 9 W., W. M.

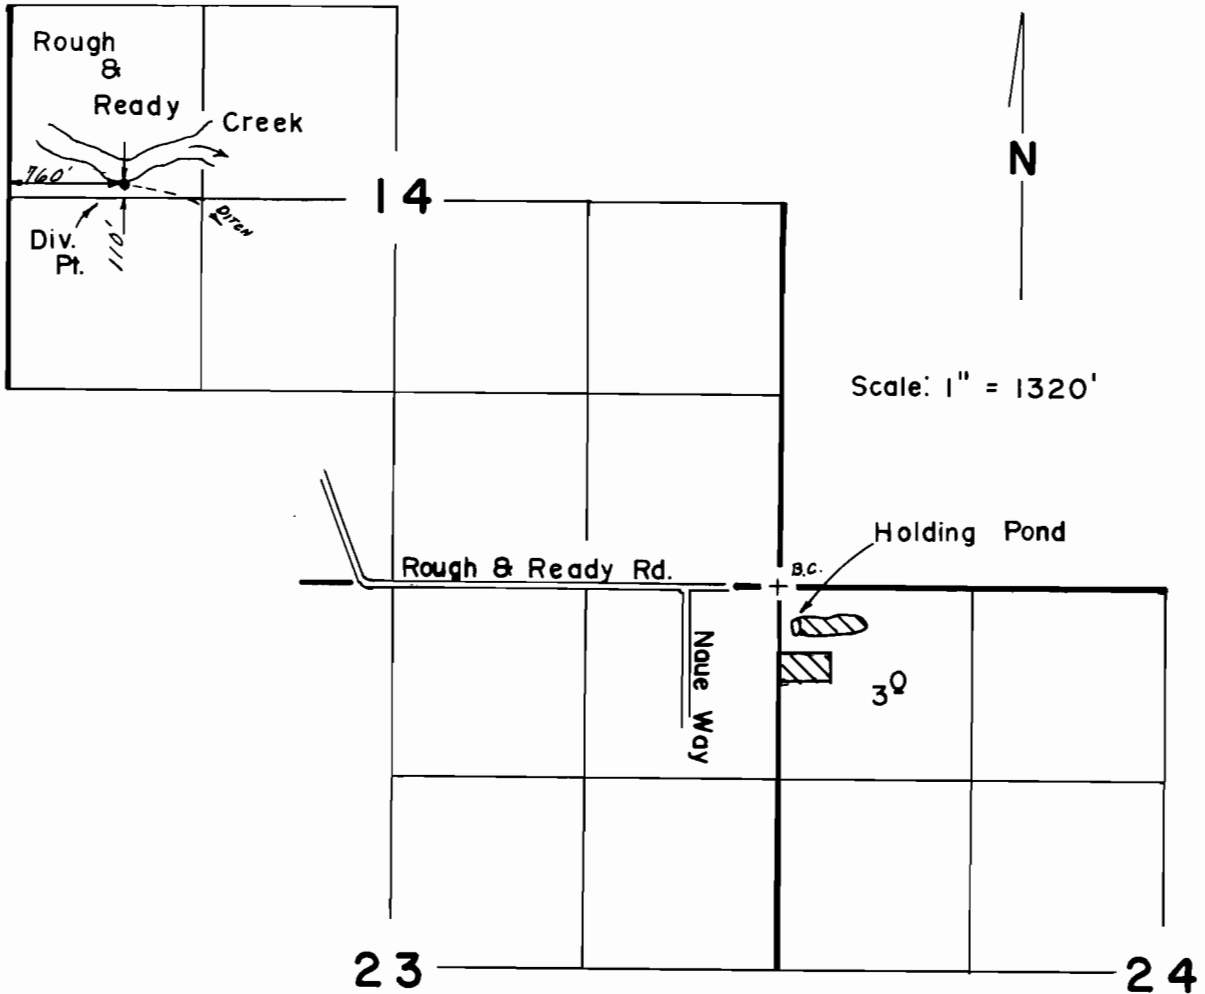

## FINAL PROOF SURVEY UNDER

Application No. 55248 Permit No. 41584...  
IN NAME OF

DELMONT F. JOHANN.....

Surveyed APR...10.. 1986, by B...S...JAMES...