


T. 20 S. R. 3 W. W.M.
SEC. 10

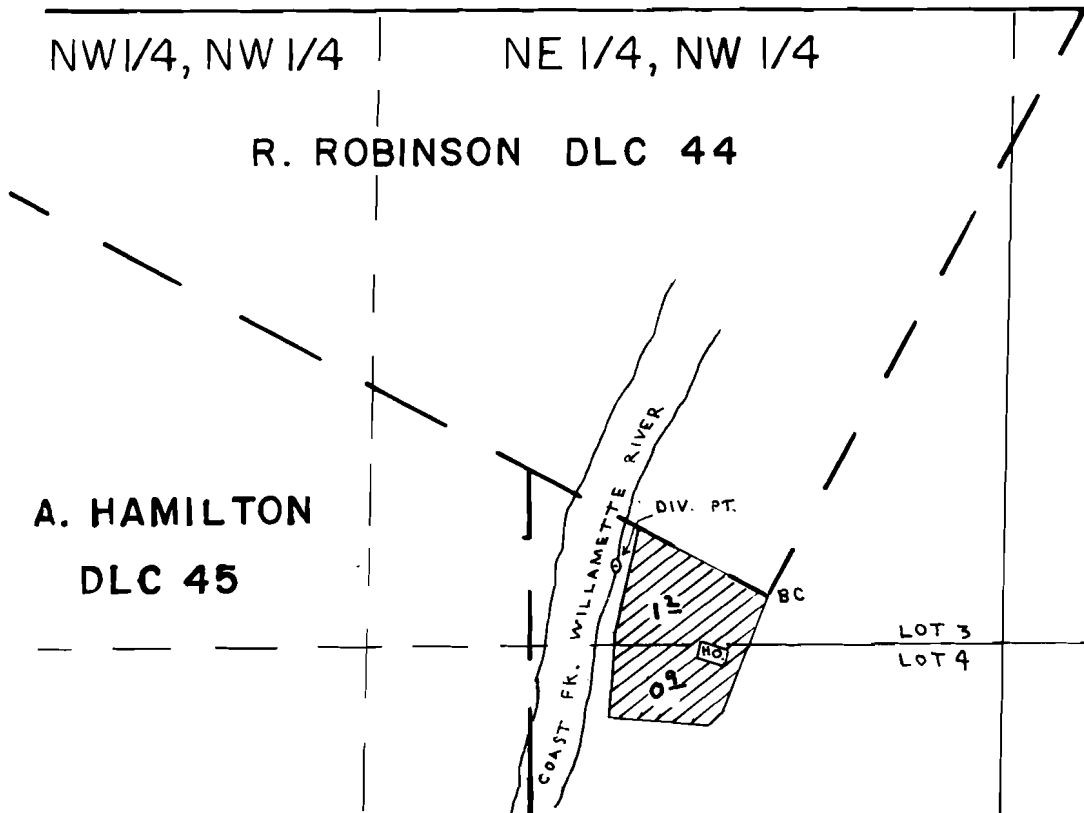

DIV. PT. LOC. 60' N & 315' W OF SE COR. DLC 44

SCALE 1" = 400'

FINAL PROOF SURVEY
UNDER

Application No. 55582. Permit No. 41656
IN NAME OF

BURTON H. & PEARL E. FORGEY

Surveyed AUG 29 1984, by P. PAGTER