


T. 37 S., R. 7 W., W. M.

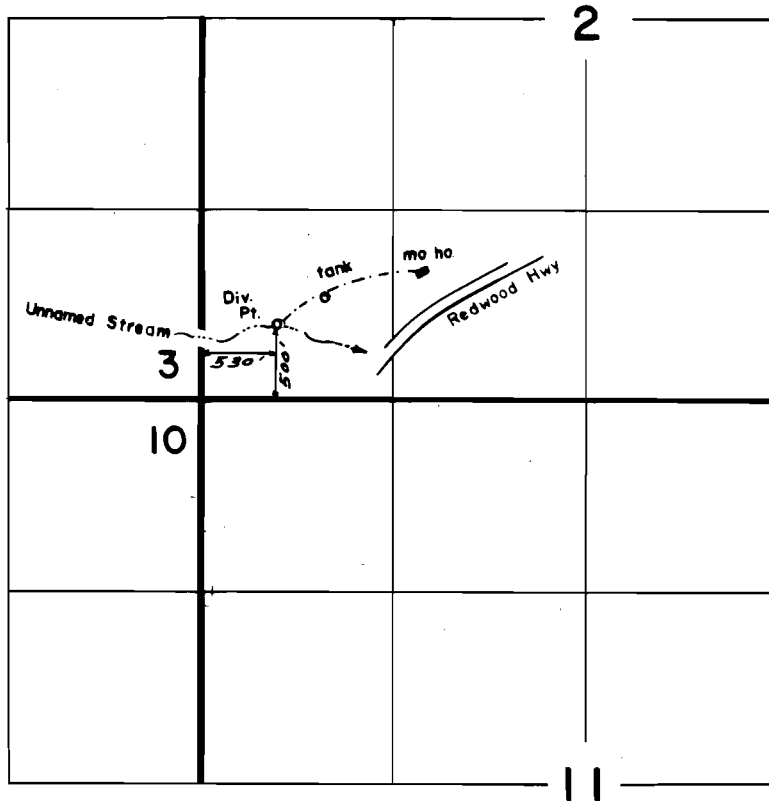

Scale: 1" = 1320'

FINAL PROOF SURVEY
UNDER

Application No. 55642 Permit No. 41684....
IN NAME OF

.....JEFFREY W. PETERSON.....

Surveyed JUL. 20 1986, by B. S. JAMES..