


T. 9S., R. 4W., W. M.

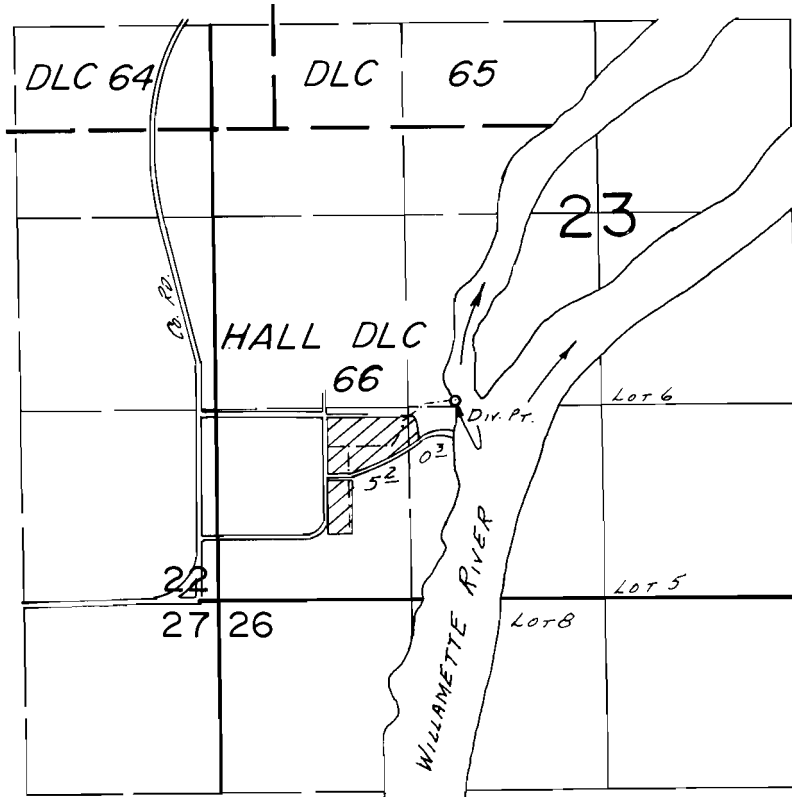

Div. Pt. Loc.: 1360 N. & 1640 E. FROM SW COR. SEC. 23.

SCALE: 1" = 1320'

### FINAL PROOF SURVEY UNDER

Application No. 55649. Permit No. 41689.....  
IN NAME OF

.....DAVID D. BREEDEN.....

Surveyed Aug. 10.... 19.84., by L. M. TOLL.....