


T.37S., R.7W., W.M.

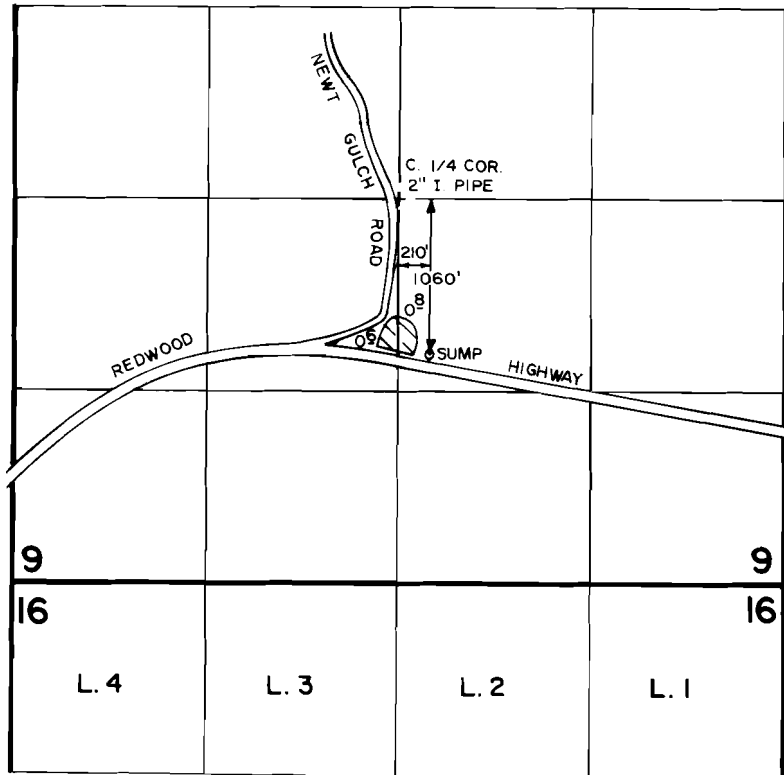

FINAL PROOF SURVEY
UNDER

Application No. 55687 Permit No. 41715
IN NAME OF

JAMES E. MALLOY

Surveyed OCT. 25 1983, by B. S. JAMES

SCALE: 4" = 1 MILE