


T. 3N. R. 10W., W.M.

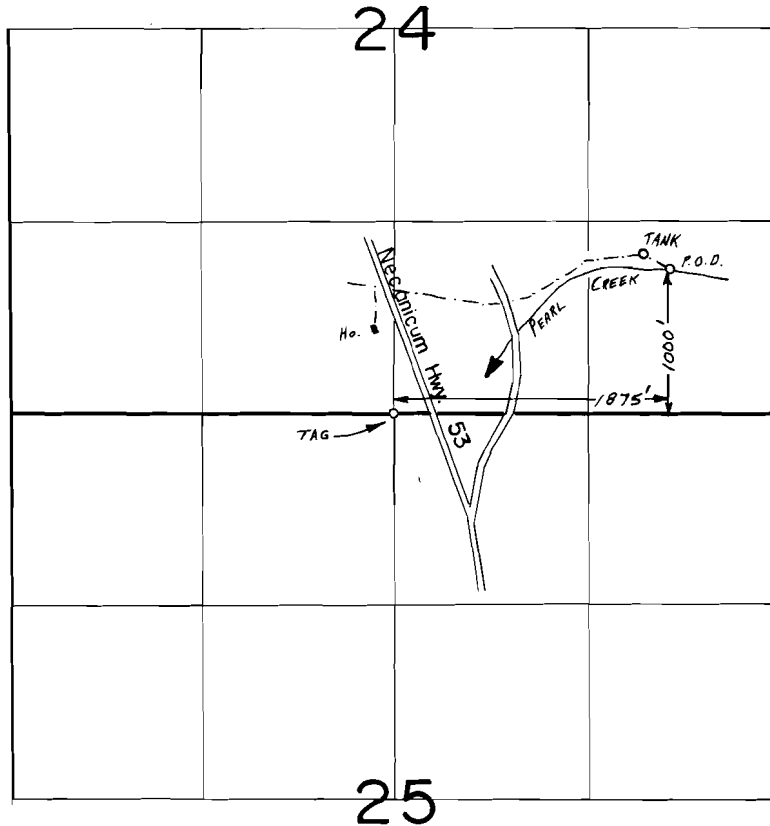

Scale : 1" = 1320'

FINAL PROOF SURVEY UNDER

Application No. 56307... Permit No. 41965.....
IN NAME OF

JAMES or EDITH GRASSETH

Surveyed Oct. 10... 1983, by P. Pagter.....