

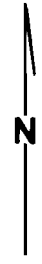


T. 33 S., R. 2 E., W. M.

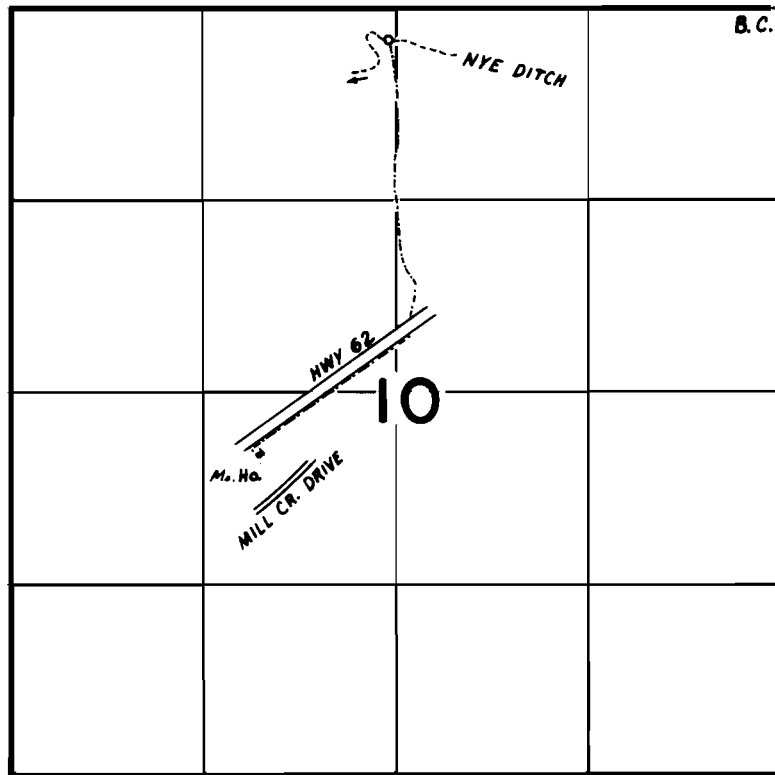

SCALE: 1" = 1320'

T. 32 S., R. 3 E., W. M.

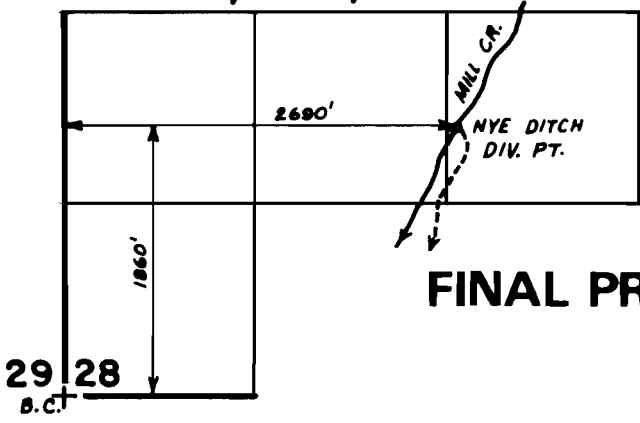

FINAL PROOF SURVEY UNDER

Application No. **58593** Permit No. **44239**
IN NAME OF

CARL G. ADAMS c/o VELA ADAMS

Surveyed **MAY 25**, 19**83**, by **B.S. JAMES**