


T. 5S., R. 3W., W.M.

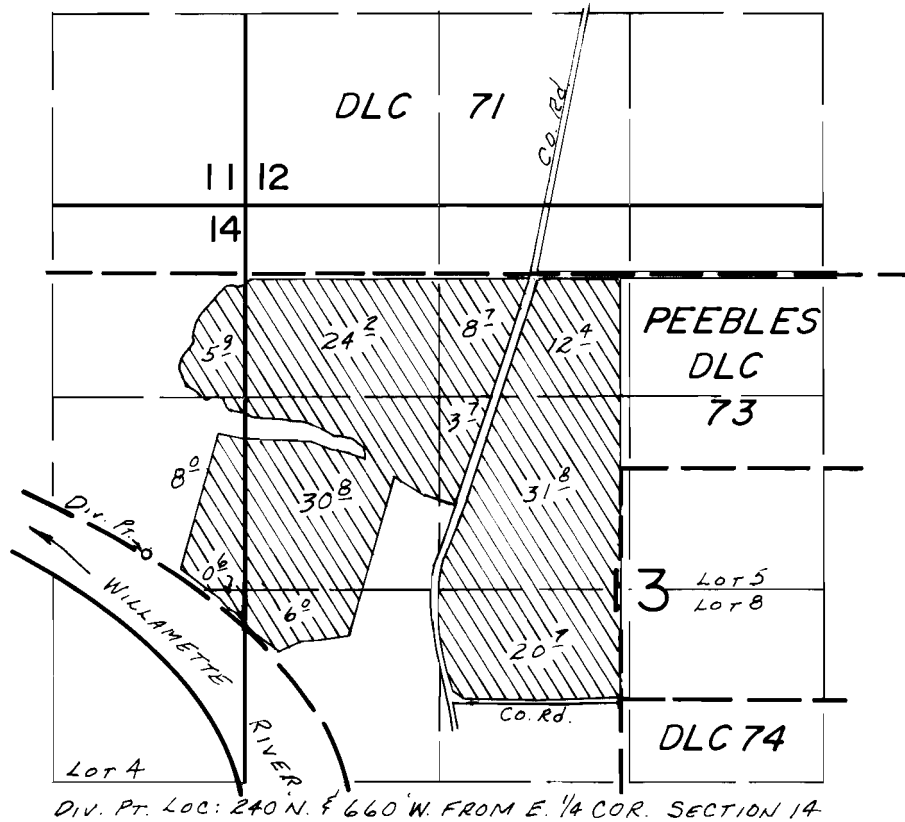

**FINAL PROOF SURVEY**  
UNDER

Application No. 55567 Permit No. 41648  
IN NAME OF

DONALD F. SAALFELD

Surveyed Sept. 28, 1983, by L.M. TOLL