


T. 32 S. R. 6 W. W. M.

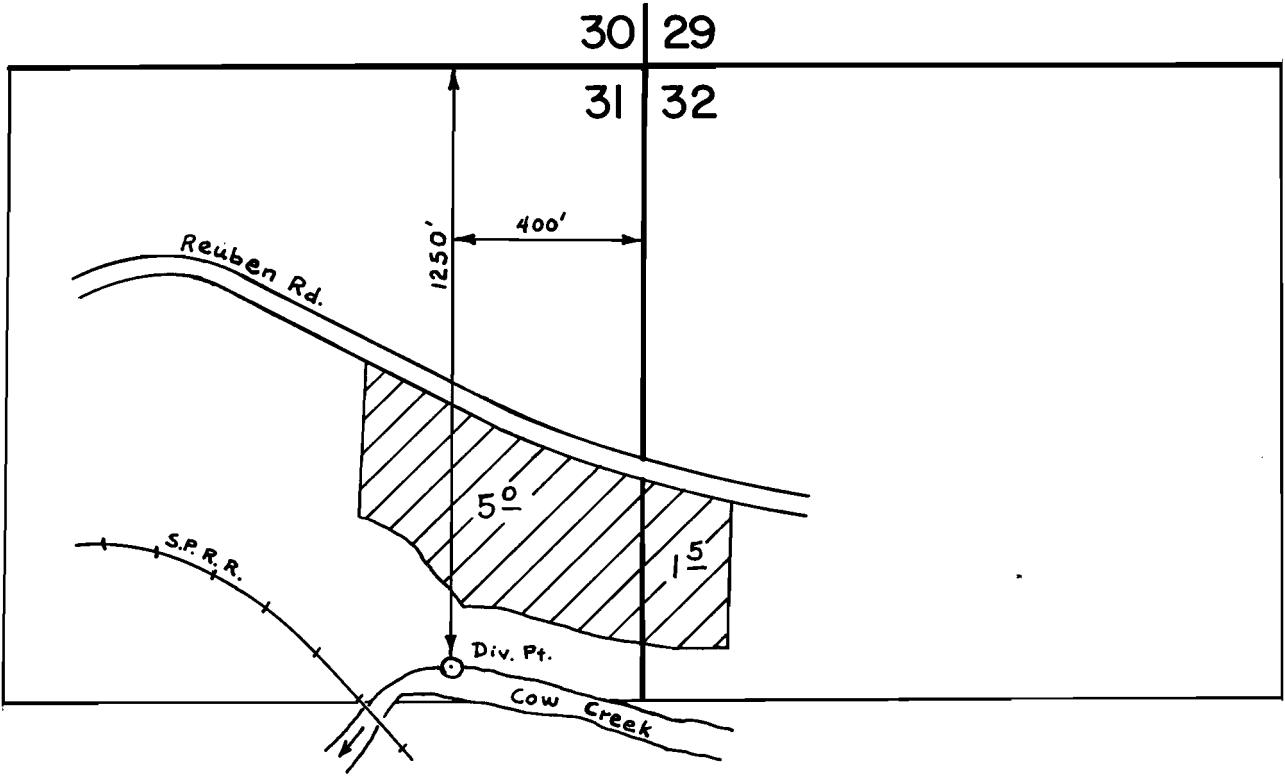

SCALE: 1" = 400'

FINAL PROOF SURVEY
UNDER

Application No. 50106 Permit No. 37649

IN NAME OF

JAMES D. CHITWOOD

Surveyed June 15 1978, by D. Sparks