

Surv.

15

16


17

Note: Streams, except in the vicinity
of irrigated land, sketched in
approximate location.


22

21

20

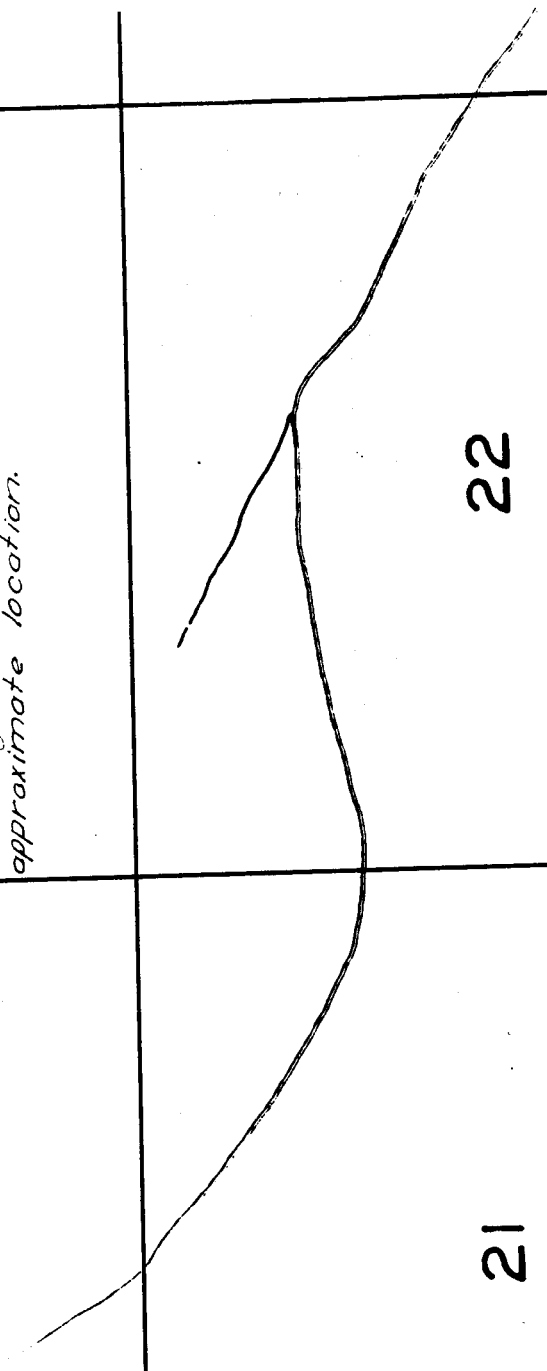

TOWNSHIP 8 S., RANGE 22 E.

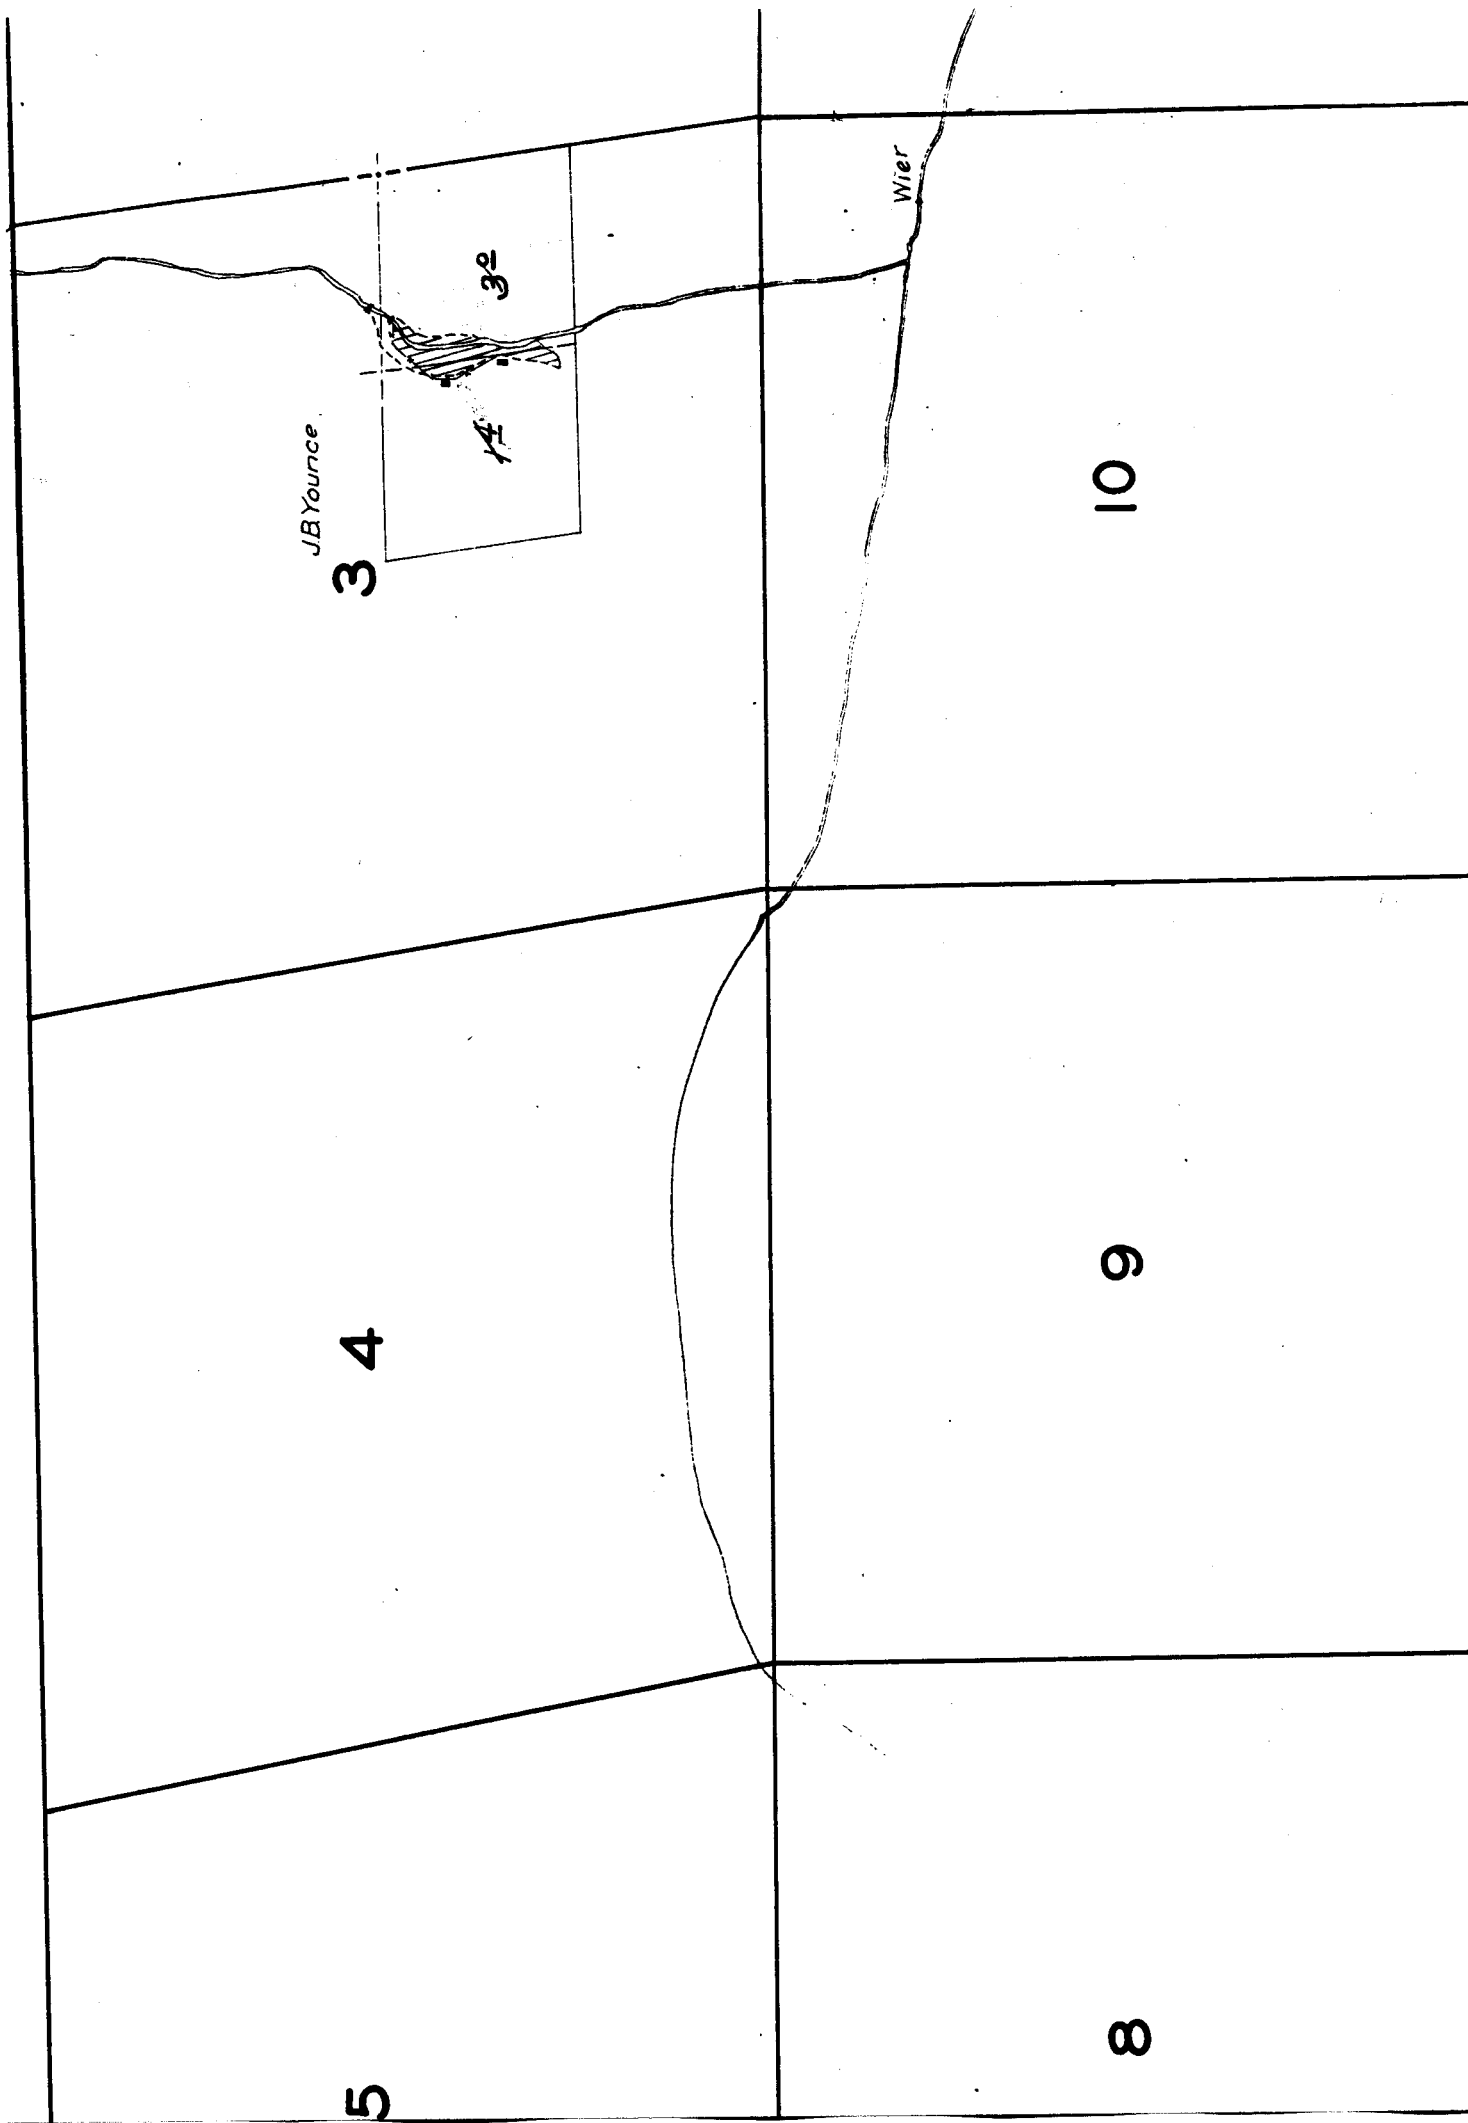

30

29

28

31

32

33

27

26

25

34

35

36

SERVICE

R.C. Jenkins

Oregon-California Live Stock Co.

CREEK

John Day Highway

R.P. Parrish

ms, except in the vicinity
of land, sketched in .

15

Surveyed Oct. 27, 28, 29, 1925.


14

13

22

23

24

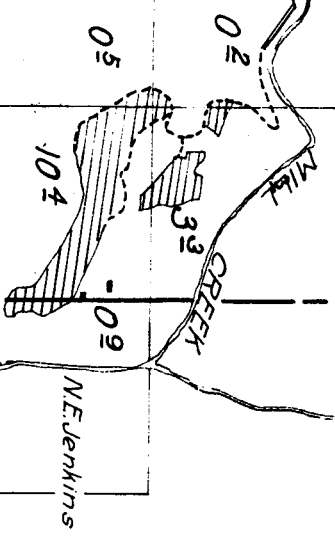

21

22

28

27

33

34

6

5

7

8

18

17

2

1

Lot 7

Lot 1

Lot 2

LITTLE SERVICE
Rocks Sage Brush

12

Oregon-California Live Stock Co.

11

Surveyed Oct. 27, 28, 29, 1925.

14

13

18

17

16

19

20

21