


67-5110
38092
44007
51865 TS238
57543

T.26S.R.15E.W.M.

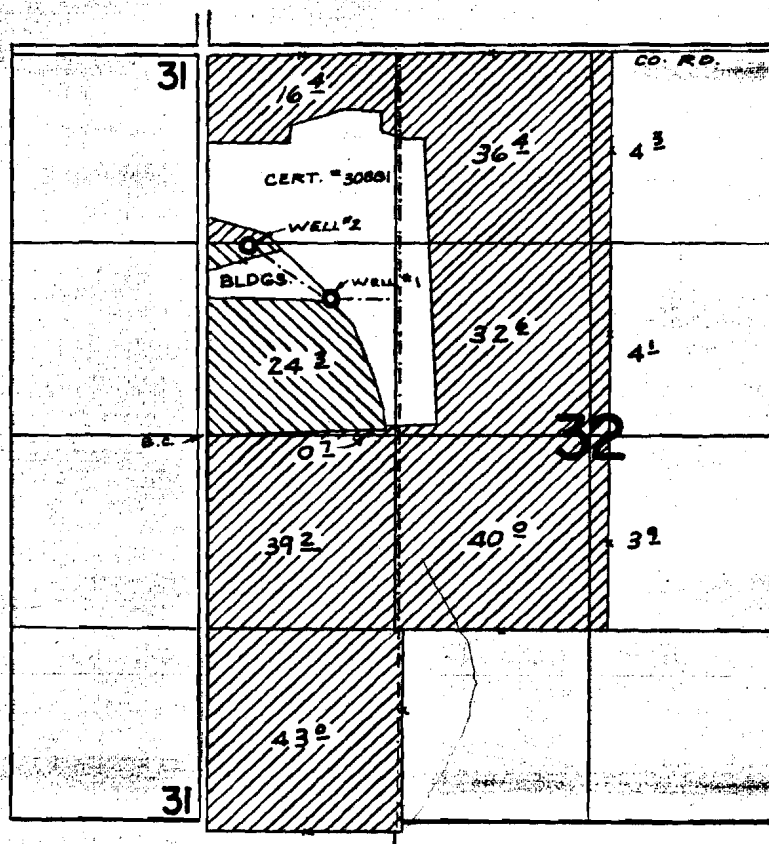

 PRIMARY  SUPPLEMENTAL

FINAL PROOF SURVEY
UNDER

Application No. G-3221 Permit No. G-3020
IN NAME OF

ROBERT R. TUTTLE & ESTATE OF GERALDINE TUTTLE

Surveyed JUNE 23, 1970, by R. MUCKEN