


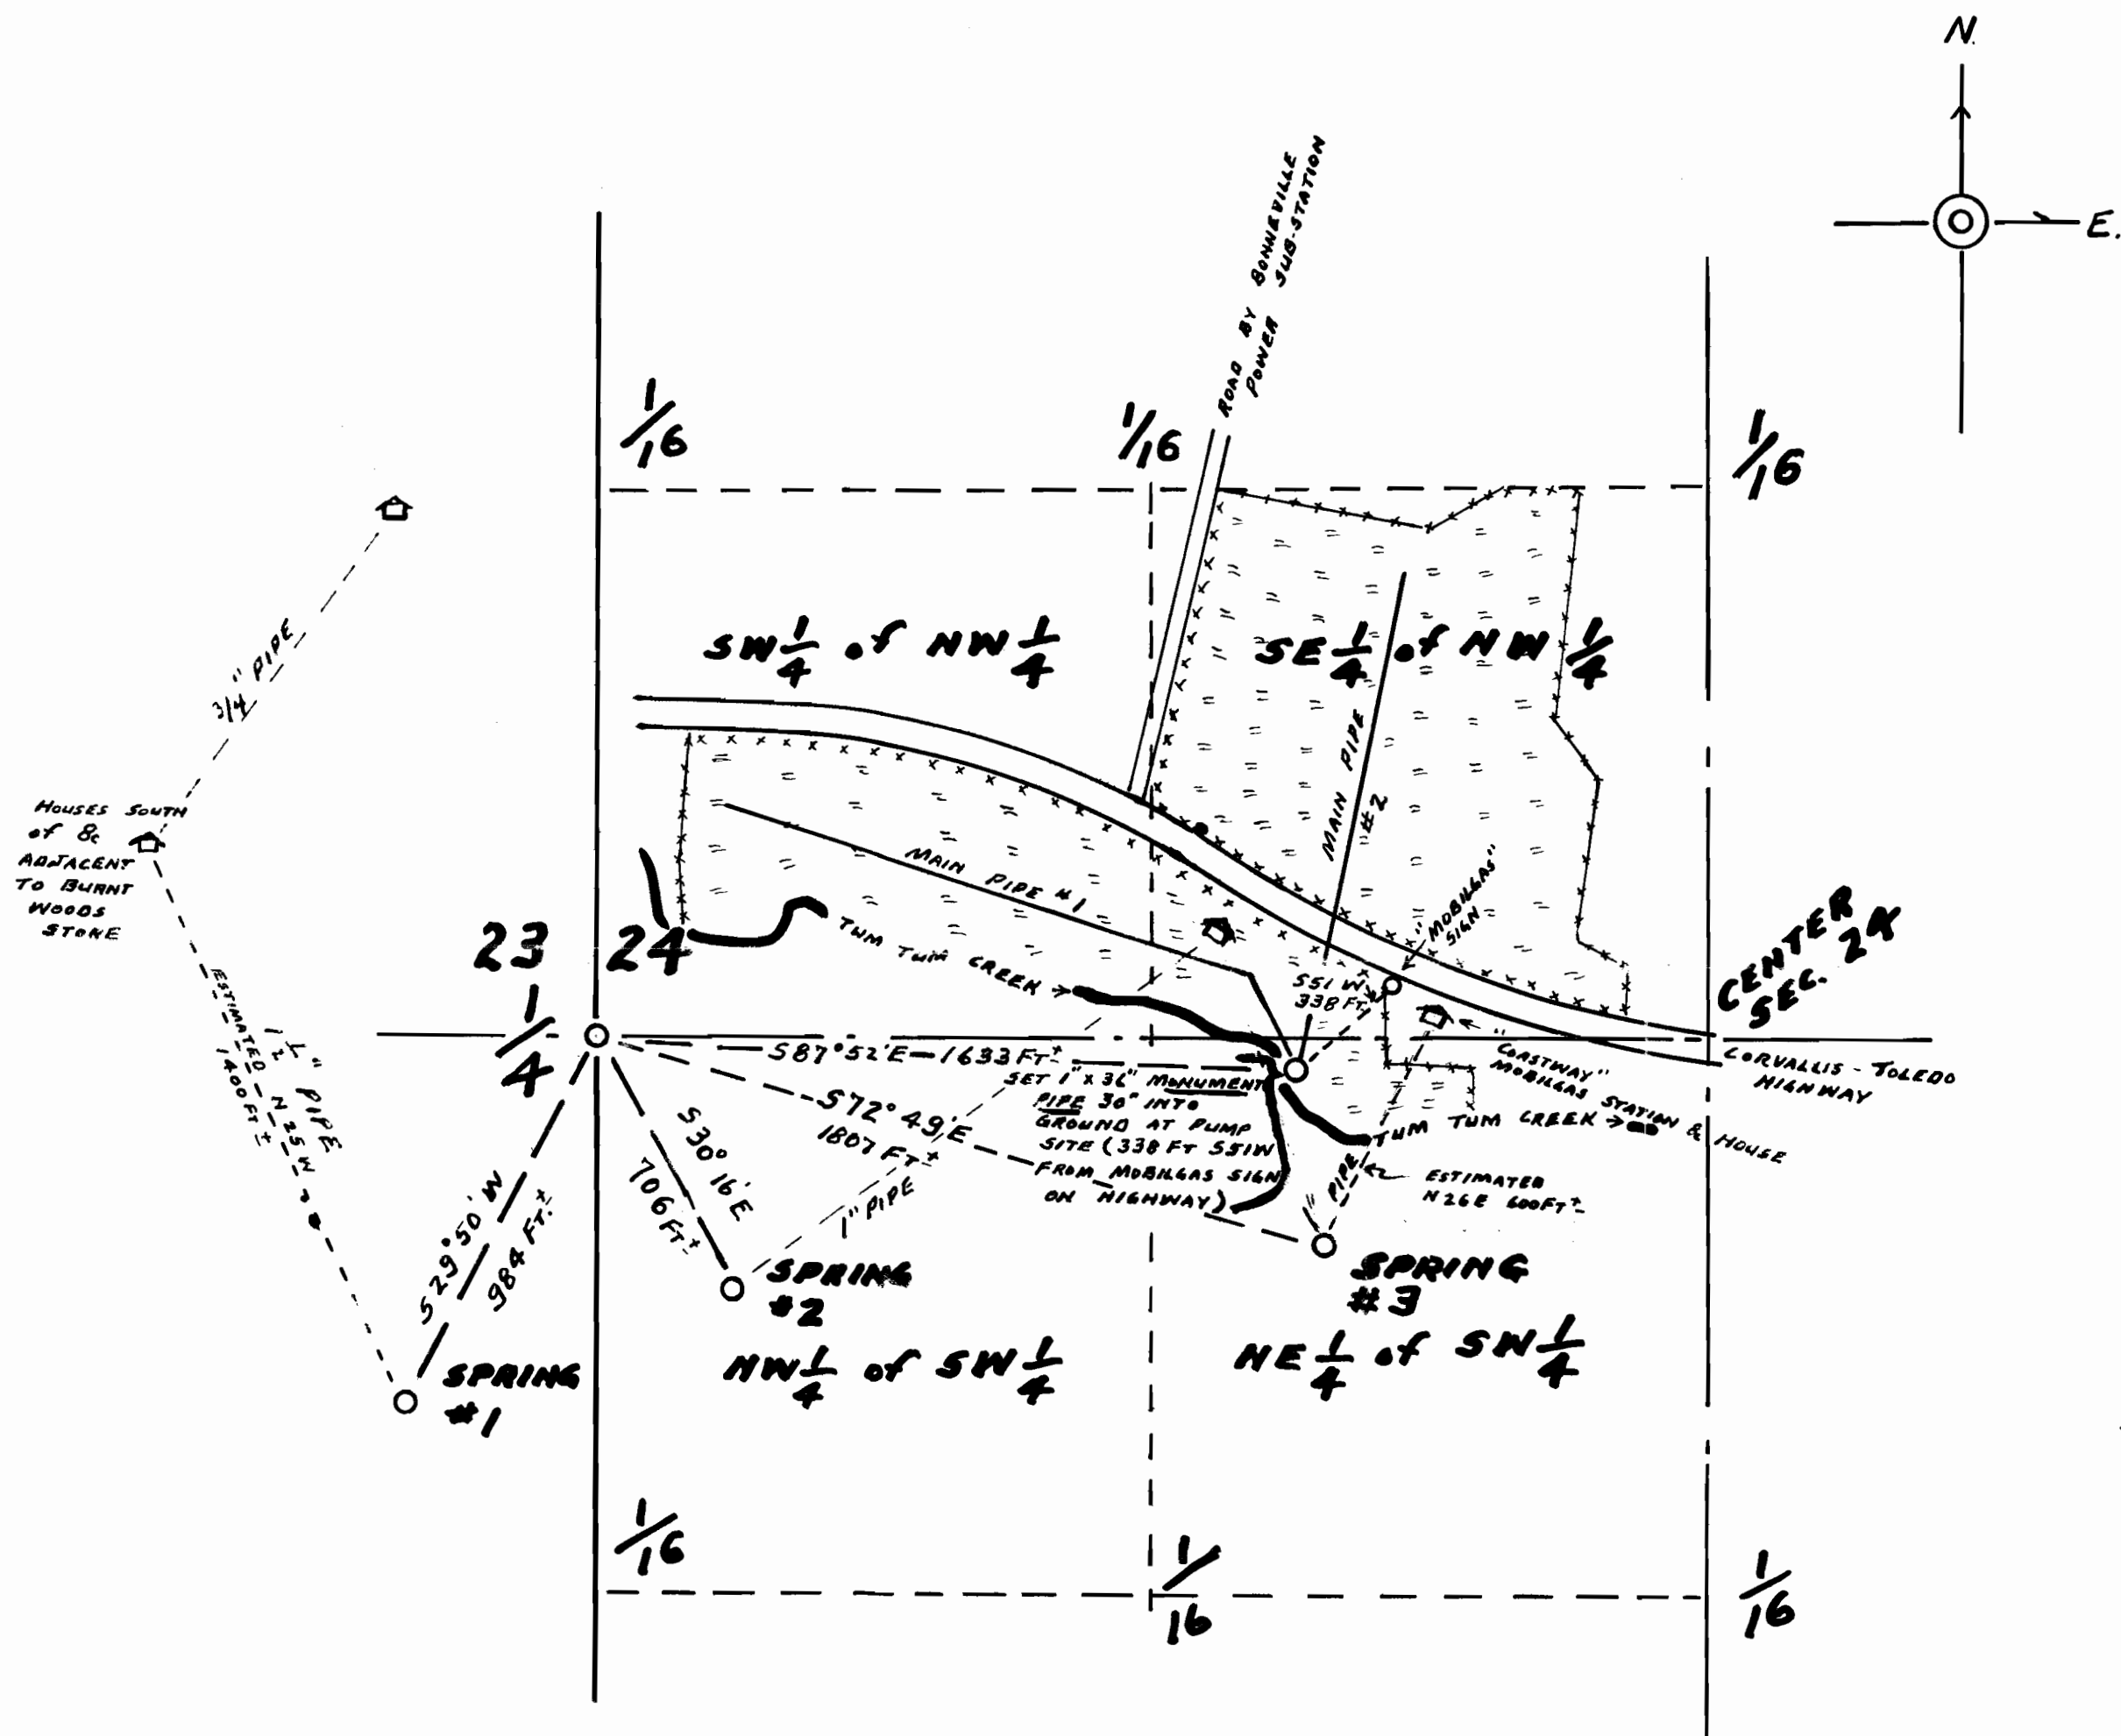

WATER RIGHT MAP  
for  
**PERRY DOWNING**

SECS. 23 & 24, T11S, R8N, W.M.  
BLUNT WOODS, LINCOLN COUNTY,  
OREGON

SCALE 1" = 400 FT  
STAFF COMPASS & CHAIN  
MAG. DECL. 21°30'  
FEB. '56

BERT W. LUBELL  
by HOWARD E. TAYLOR  
REG. ENGRS.

I, HOWARD E. TAYLOR of LEBANON, OREGON  
DO HEREBY CERTIFY THAT THIS MAP WAS  
MADE FROM NOTES TAKEN DURING AN ACTUAL  
SURVEY MADE BY ME ON FEB. 4, 1956; THAT  
THE MONUMENT SHOWN ON THIS MAP CONSISTING  
OF 1" X 36" PIPE IS S87°52' E 1633 FT ±  
FROM WEST 1/4 SEC. 24, T11S, R8N, W.M.

H. E.  
Taylor

| SHADED ACREAGES TO BE IRRIGATED: |                  |               |
|----------------------------------|------------------|---------------|
| (1).                             | SW 1/4 of NW 1/4 | 12 ACRES ±    |
| (2).                             | SE 1/4 of NW 1/4 | 30 ACRES ±    |
| (3).                             | NE 1/4 of SW 1/4 | 1 1/2 ACRES ± |