


T.27S.R.6W.W.M.

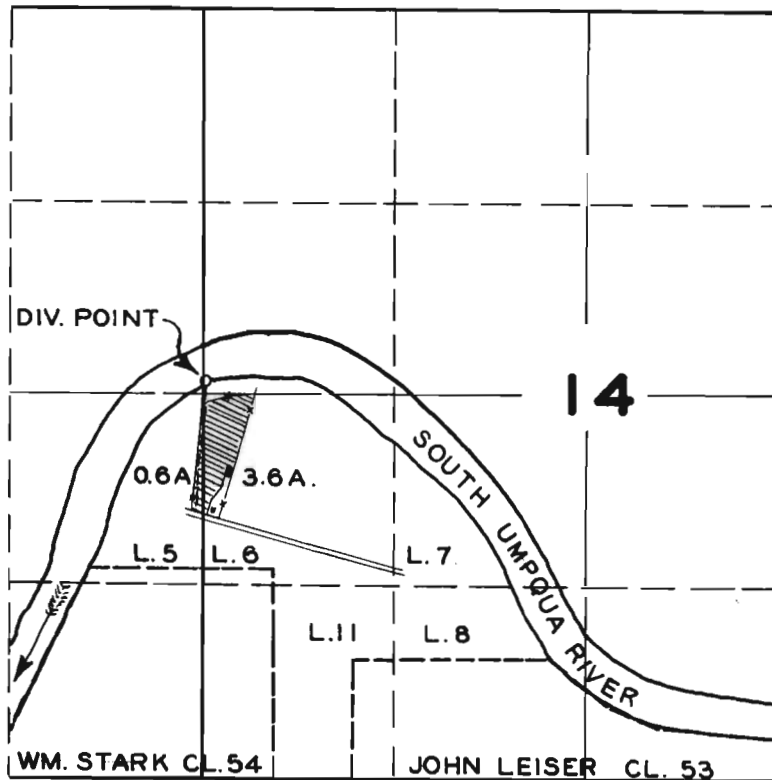

POD 80' N & 10' E from W 1/4 cor

FINAL PROOF SURVEY

UNDER

Application No. 22309 Permit No. 17592

IN NAME OF

.....BERT J. GILBERT.....

Surveyed MAY 26, 1950, by H.L. COFFMAN.