




T. 26 S., R. 6 W., W.M.

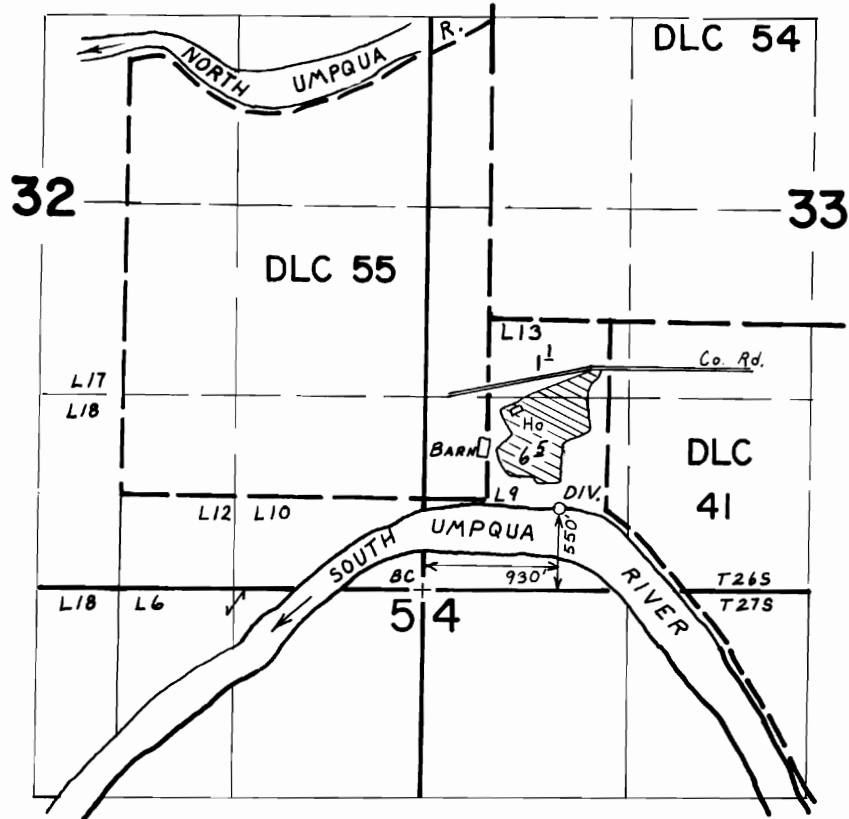

SCALE: 4" = 1 mile

**FINAL PROOF SURVEY**  
UNDER

T-5290

Application No. .... Permit No. ....

IN NAME OF

.....**THOMAS F. CARTER**.....

Surveyed MAY 4, 1984, by *J.E. Cashion*.....