


T.10S.R.6W.W.M.

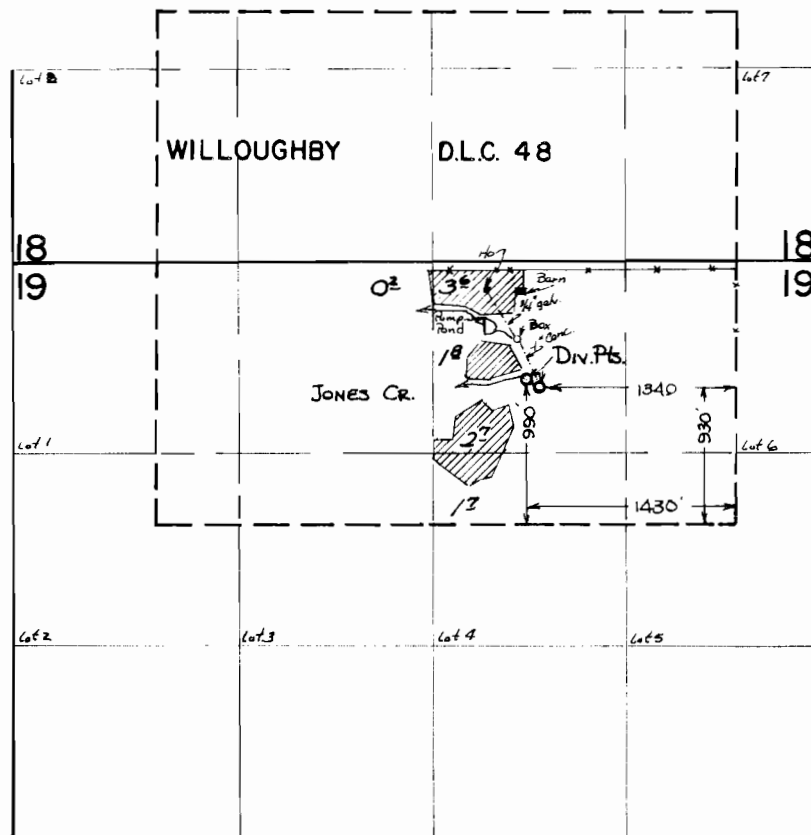

FINAL PROOF SURVEY
UNDER

Application No. 20428 ... Permit No. 16114 ...
IN NAME OF

MR. & MRS. RICHARD A. FOSTER

Surveyed 16. AUG. 1956, by C.O. BARTELS