


T. IN. R. 32E. W.M.

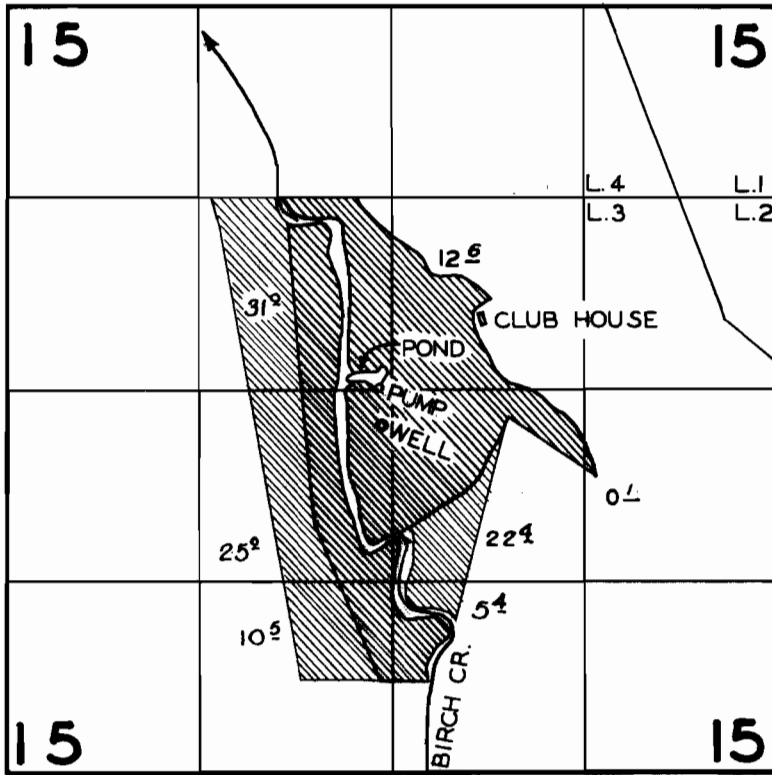

FINAL PROOF SURVEY
UNDER

Application No. G 278 Permit No. G 236
IN NAME OF

PENDLETON COUNTRY CLUB, INC.,

Surveyed JULY 12 1960 by *[Signature]*
Sept. 18 1961 by *C. J. Bartels*