


(T, 5541)

T. 25S., R. 14E., W.M.

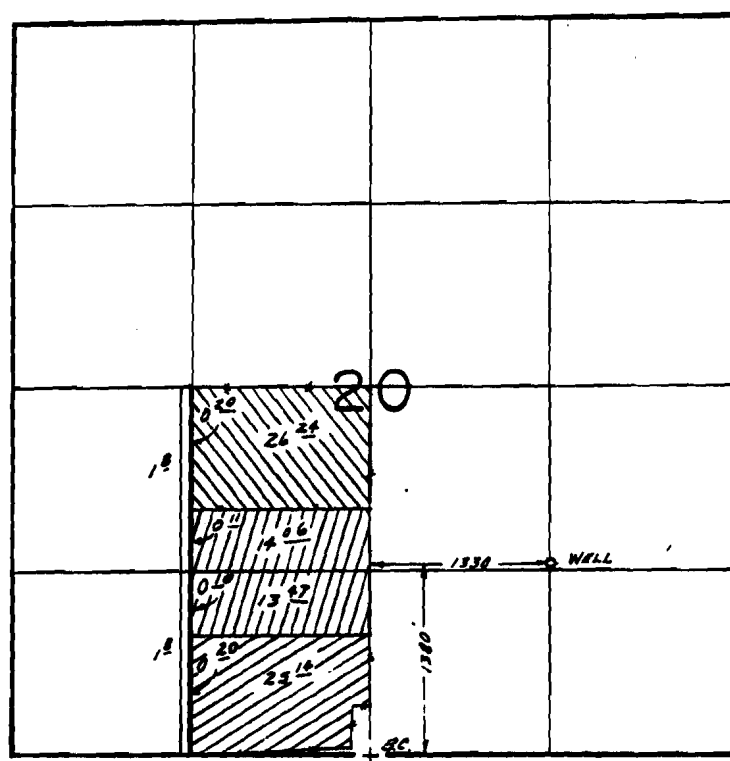

-  Tr. 5541
-  Tr. 5540
-  Tr. 5539

SCALE: 1" = 1320'

FINAL PROOF SURVEY
UNDER

Transfer No. 5539, 5540 & 5541
IN NAME OF

BANFIELD VETERINARY HOSPITAL, INC.

Surveyed Sept. 15... 19.85, by R.W. BISHOP.....