


T. 25S.R.14E.W.M.

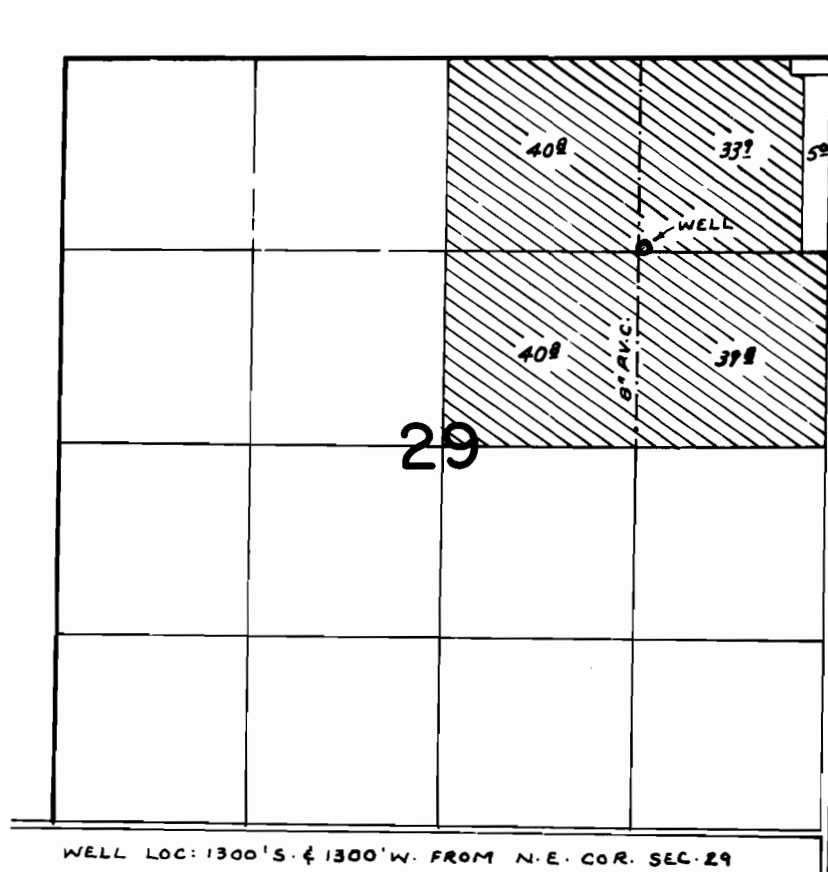

FINAL PROOF SURVEY
UNDER

Application No. *G-7398* Permit No. *G-7129*
IN NAME OF

BANFIELD VETERINARY HOSPITAL, INC.

Surveyed *AUG. 24, 1978*, by *S.P. APPLGATE*