


T. 27S., R. 3W., W.M.

SEC. 2

NESW

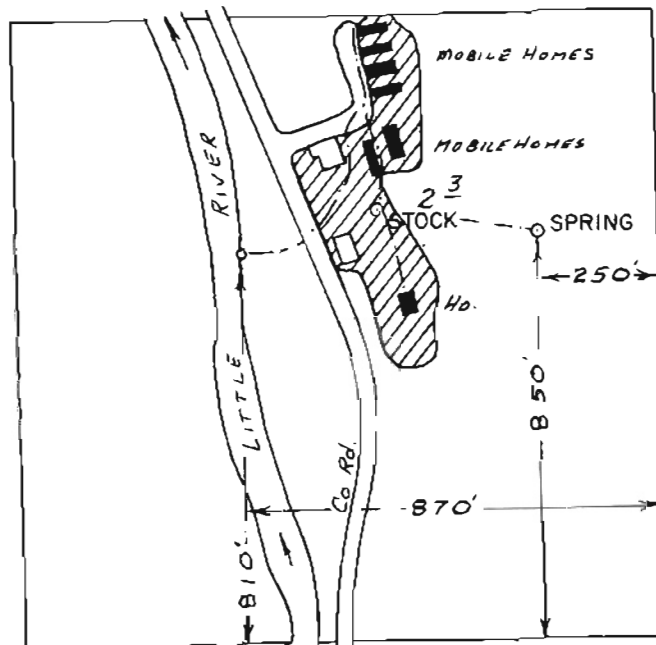

SCALE: 1" = 400'

FINAL PROOF SURVEY
UNDER

T-3292 (Irrigation & Stock)

Application No. 53562 Permit No. 43745 (Domestic Only)
IN NAME OF

MR. & MRS. BASCUM T. PAGE

Surveyed MAY 13, 1980, by J.S. DONALDSON