C-24619
57567

MAP TO ACCOMPANY APPLICATION OF C.W. BOGART
SISTERS - OREGON
SECTION 35 TOWNSHIP 14 SOUTH RANGE 10 EAST.
SCALE 8" = 1 MILE

T-4956

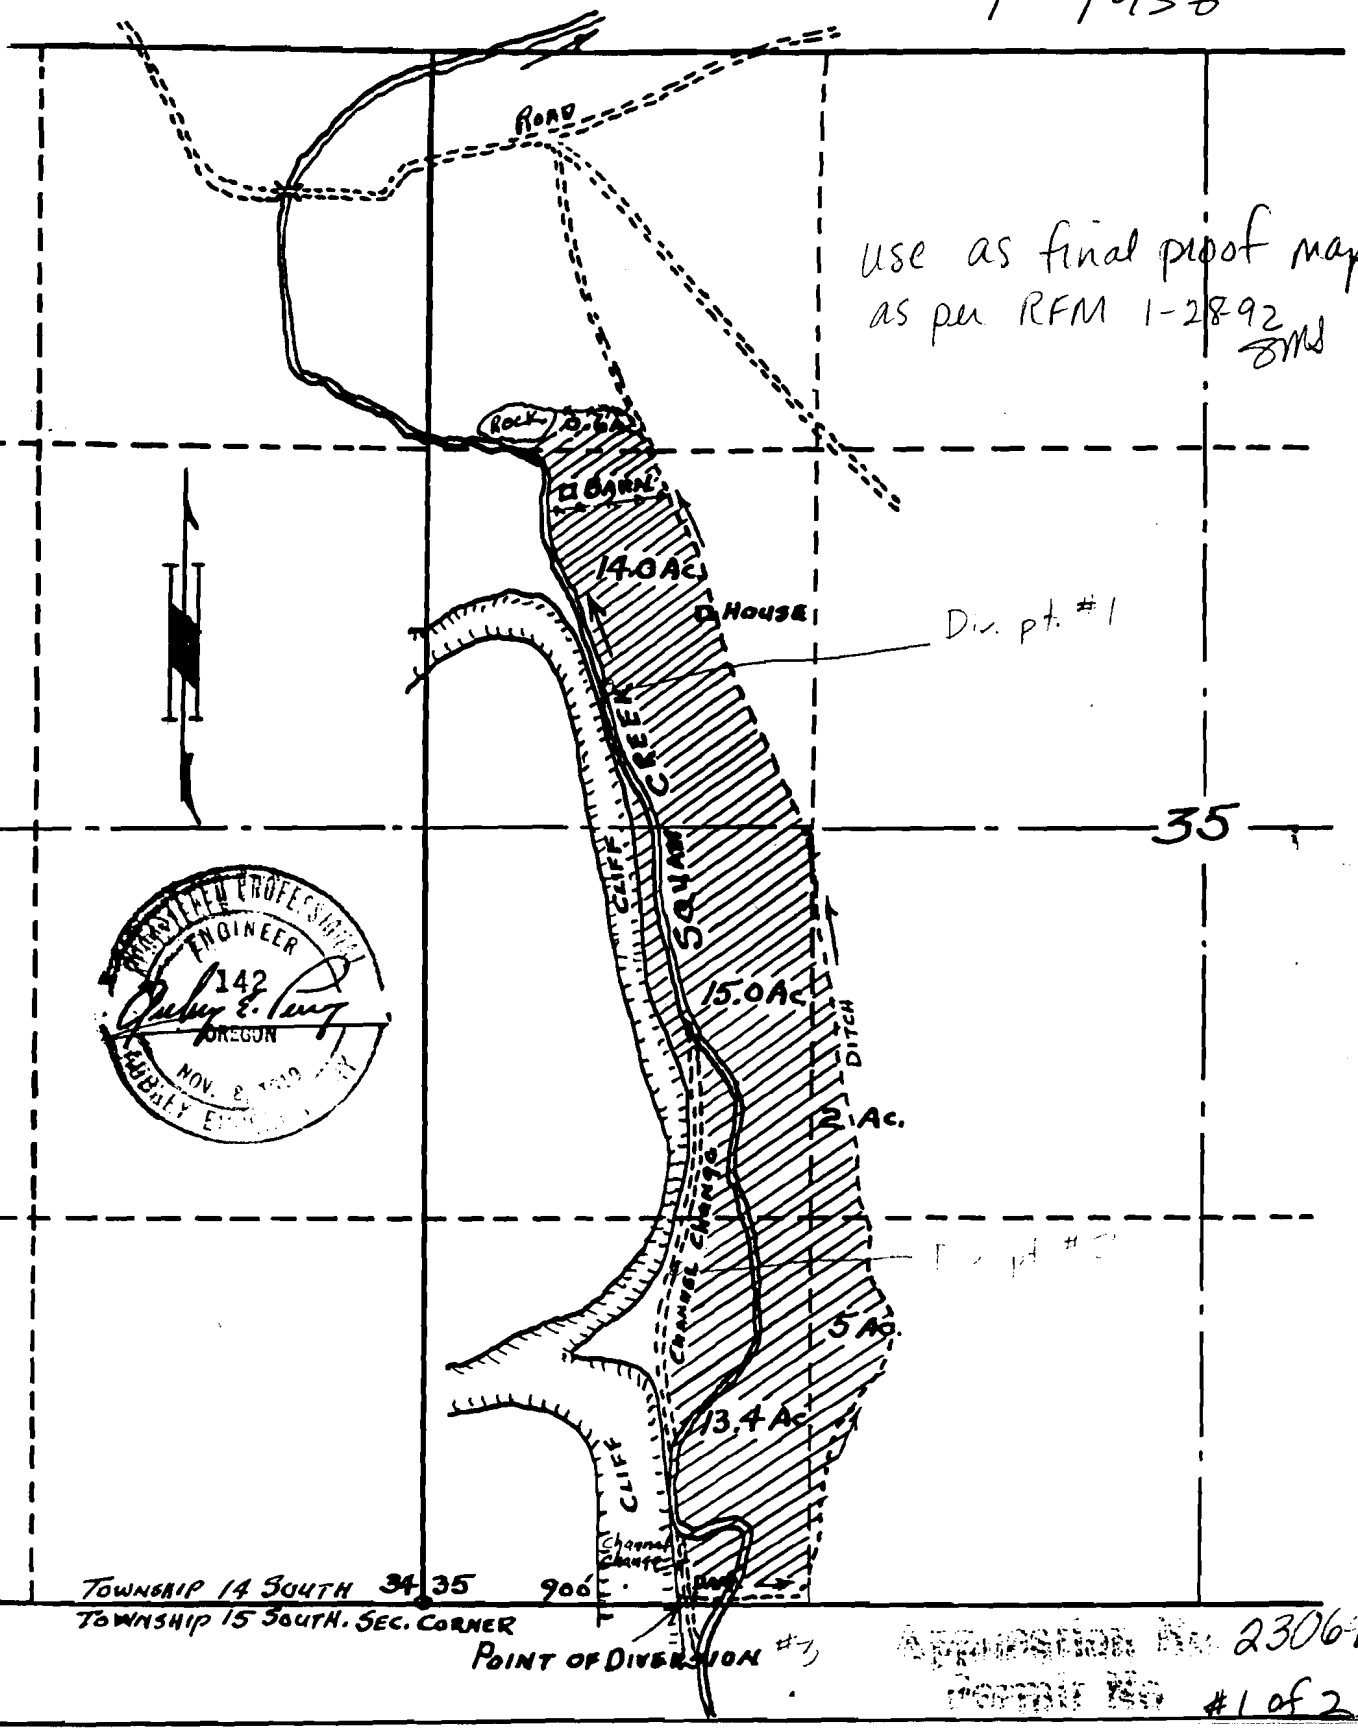

APPLICATION No. 23069
PERMIT No. #1 of 2

18203

P. 18203

MAP TO ACCOMPANY APPLICATION OF C.W. BOGART.
SISTERS - OREGON.
SECTION 35 - TOWNSHIP 14 South RANGE 10 EAST.
SCALE 8" = 1 MILE.

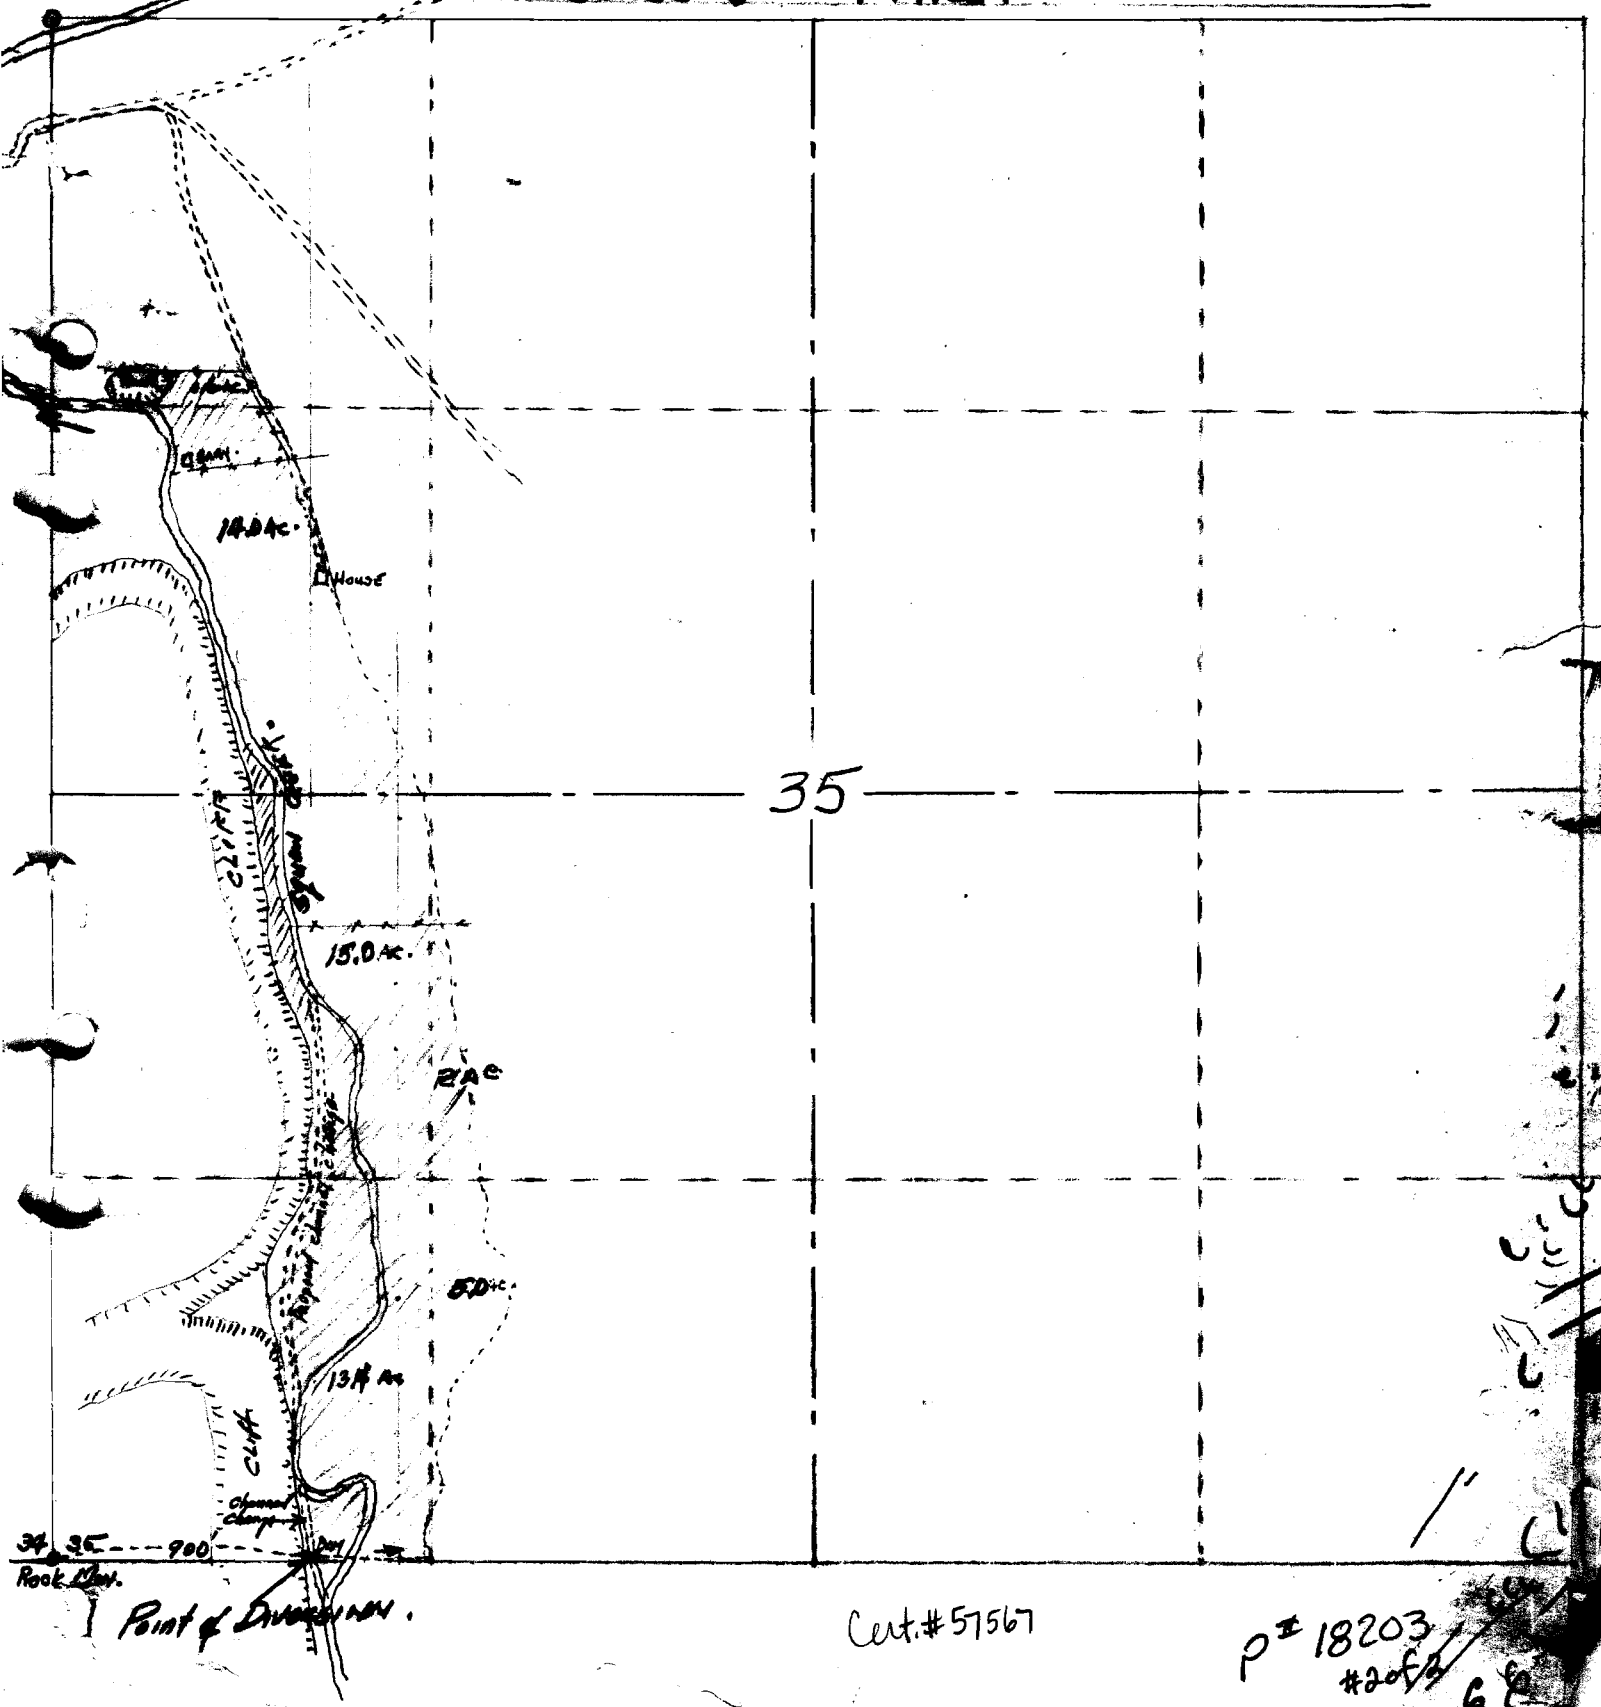

Cert. #57567

P# 18203
#2 of 2