


T. 35 S., R. 4 W., W.M.

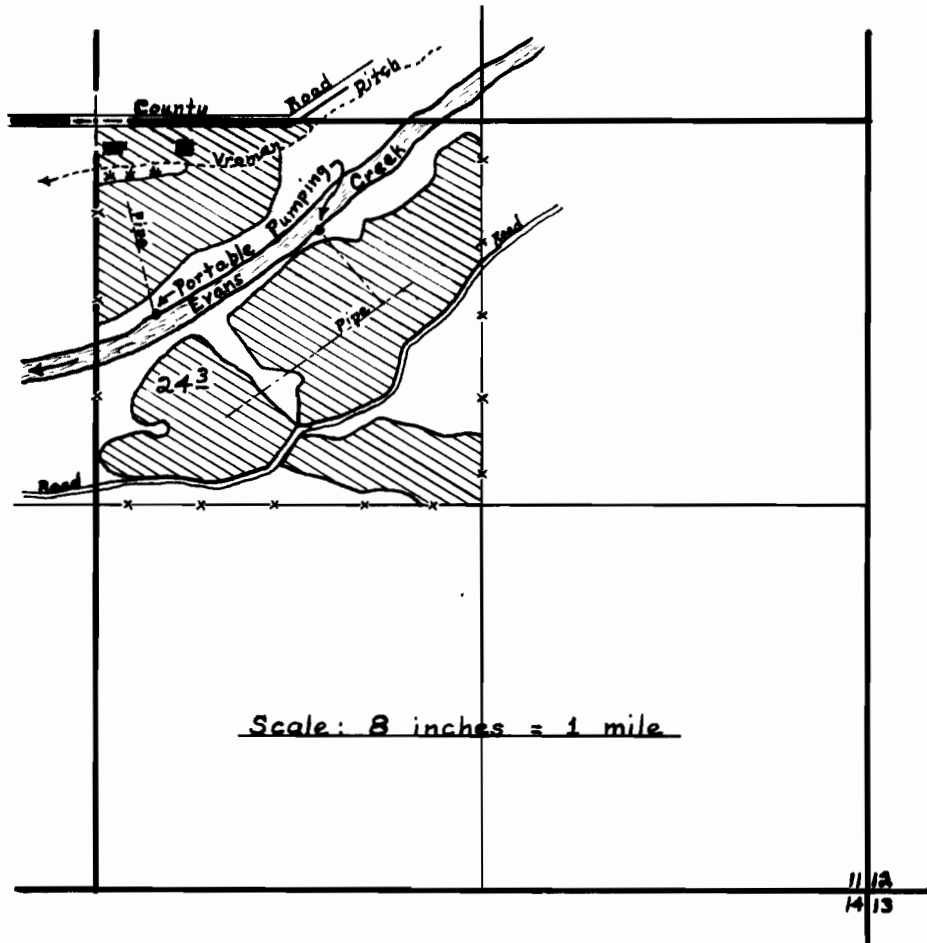

## FINAL PROOF SURVEY

UNDER

Application No. 27244. Permit No. 21437...

IN NAME OF

.....Karl M. Byers, Sr......

Surveyed Nov. 25, 1958., by D.C. Hendrix, W.M.