


U-235

57583 PR
22843

T.38S., R. 11½ E. WM.

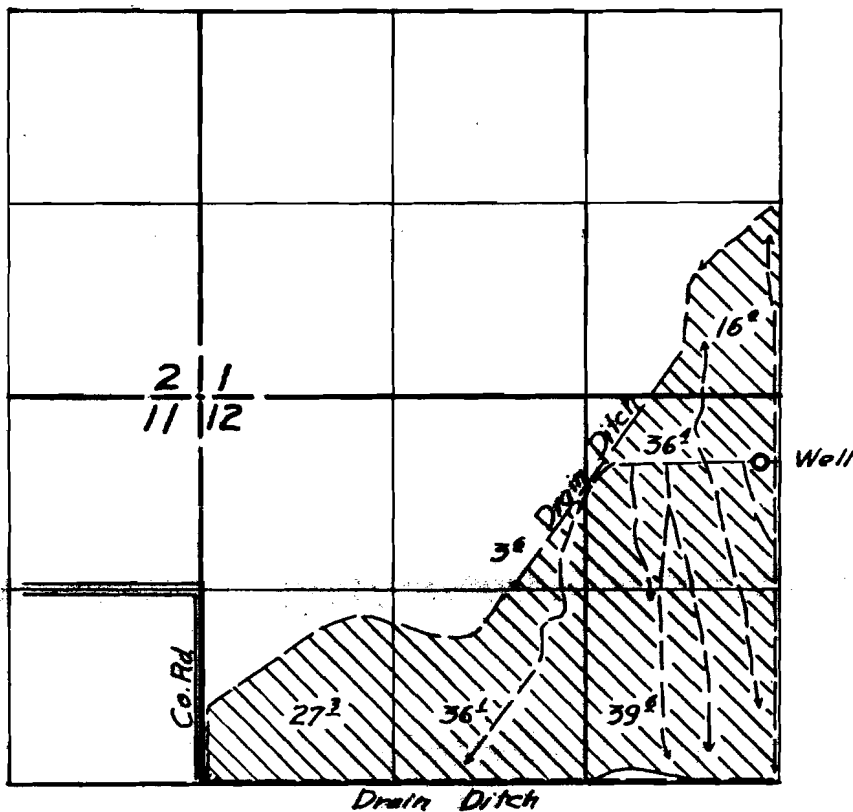

FINAL PROOF SURVEY
UNDER

Application No. U-265 Permit No. U-235

IN NAME OF

JOE VIEIRA

Surveyed 16 May 1955, by H.H. Coffman

*Portion of right has been cancelled
see Permit # U-235.*