


# T.40 S. R.3 W. W.M.

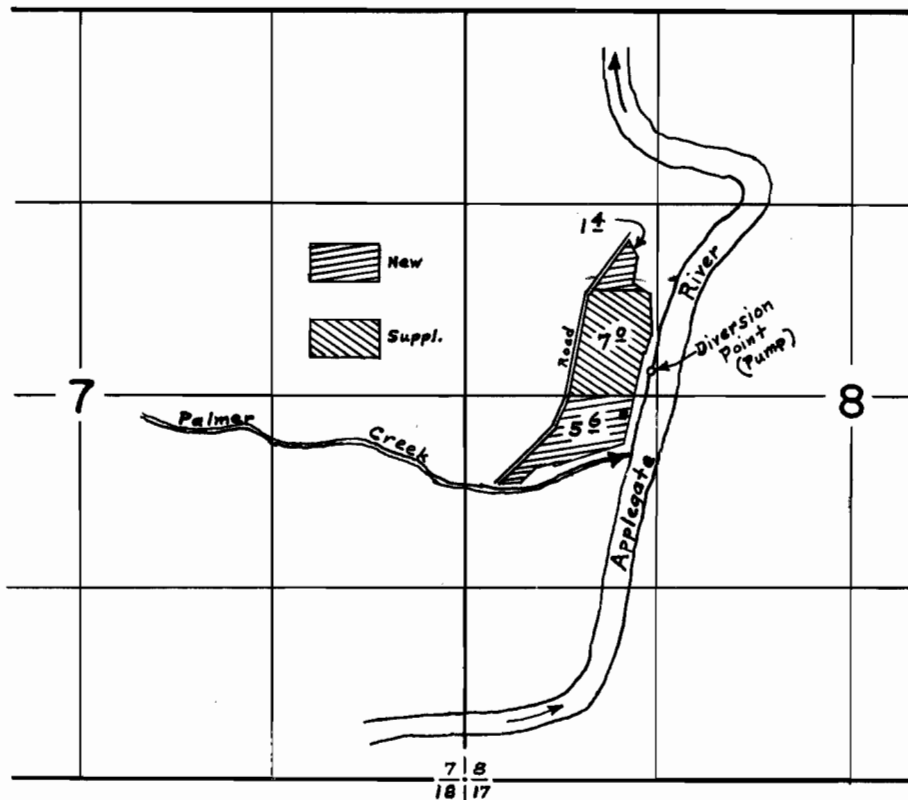

## FINAL PROOF SURVEY UNDER

Application No. 31735 Permit No. 25015...  
IN NAME OF

John S. & Pearl A. Byrne

Surveyed May 20, 1963, by C. Baker