


T. 25S. R. 12W. W.M.

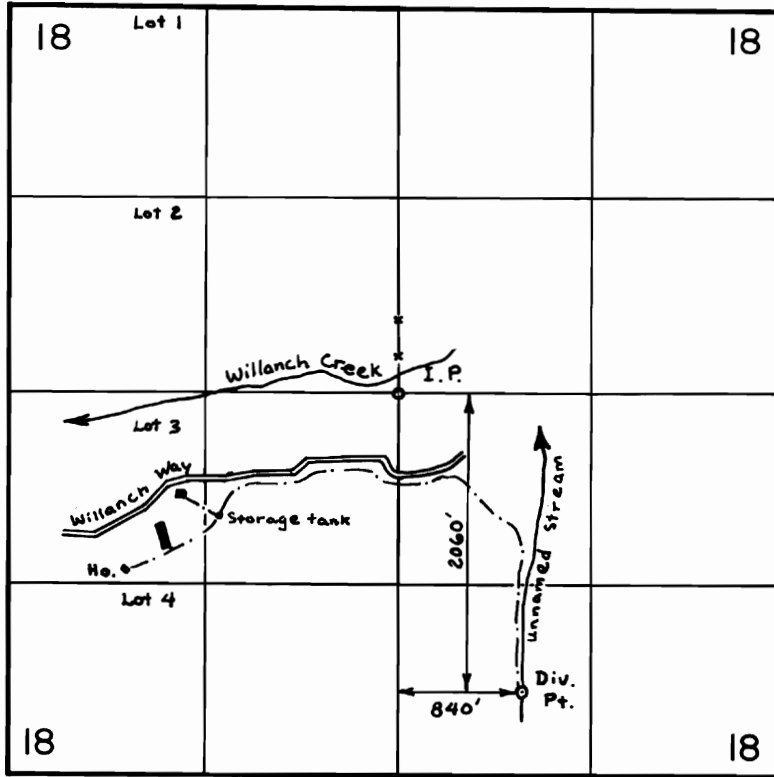

SCALE: 4" = 1mi.

FINAL PROOF SURVEY
UNDER

Application No. 55274 Permit No. 41631
IN NAME OF

FRANK B. ROOD

Surveyed May 16 1978, by D. Sparks