


T.36S., R.2W., W.M.

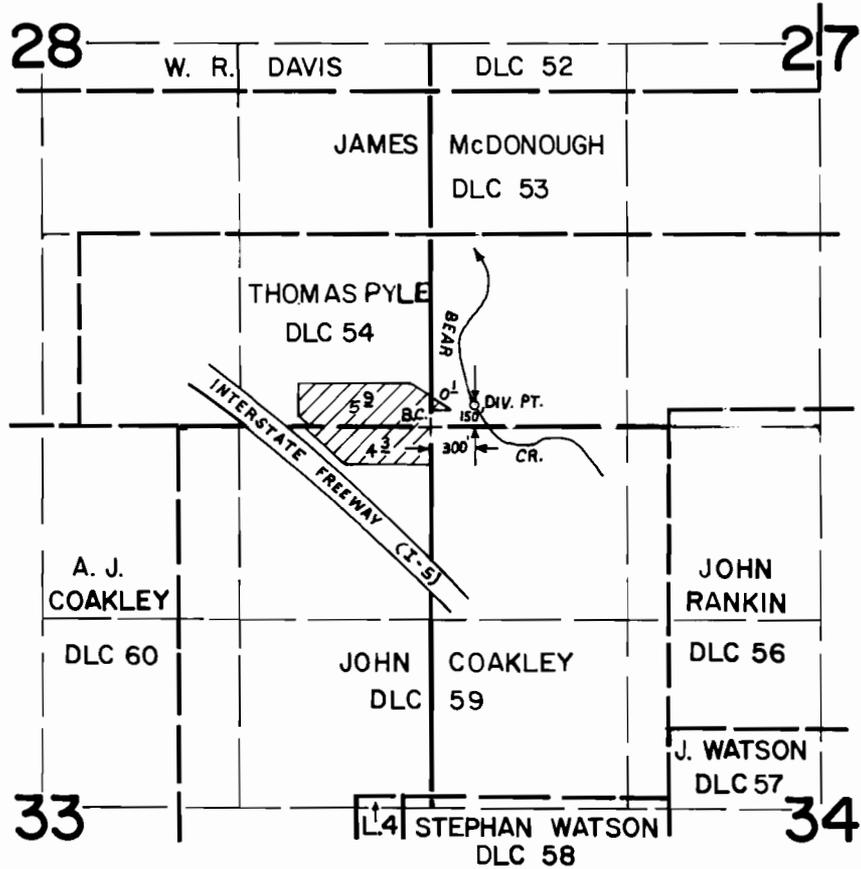

FINAL PROOF SURVEY

UNDER

TRANSFER NO. 3168

Application No. Permit No.

IN NAME OF

GREAT VALLEY DEVELOPMENT CO.

Surveyed FEB. 4, 1983, by B. S. JAMES

SCALE: 4" = 1 MILE