


T. 9S. R. 1W. W.M.

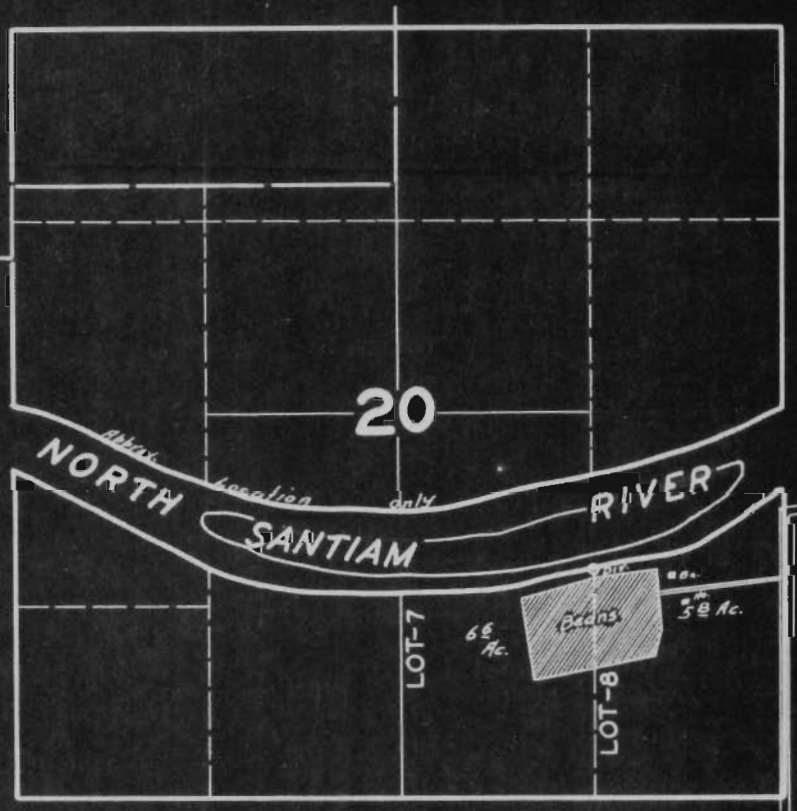

FINAL PROOF SURVEY UNDER

Application No. 19151 Permit No. 14746

IN NAME OF

MRS. ADAM SCHLIES

Surveyed JUNE 21 1945 by *[Signature]*