T.3S.R.4W.W.M.

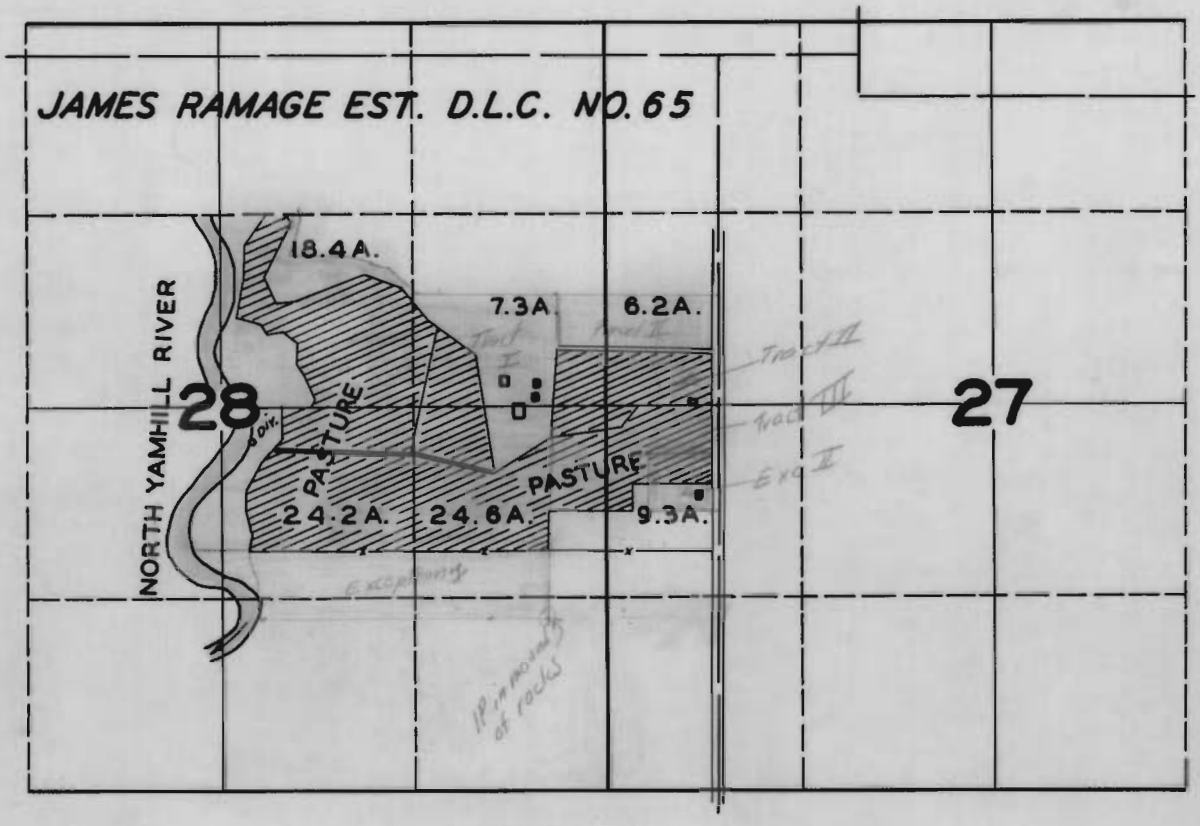

FINAL PROOF SURVEY

UNDER

Application No. 18069 Permit No. 13735

IN NAME OF

.....

Surveyed SEP. 20 1947, by JAS. E. BUNNELL

1947--F