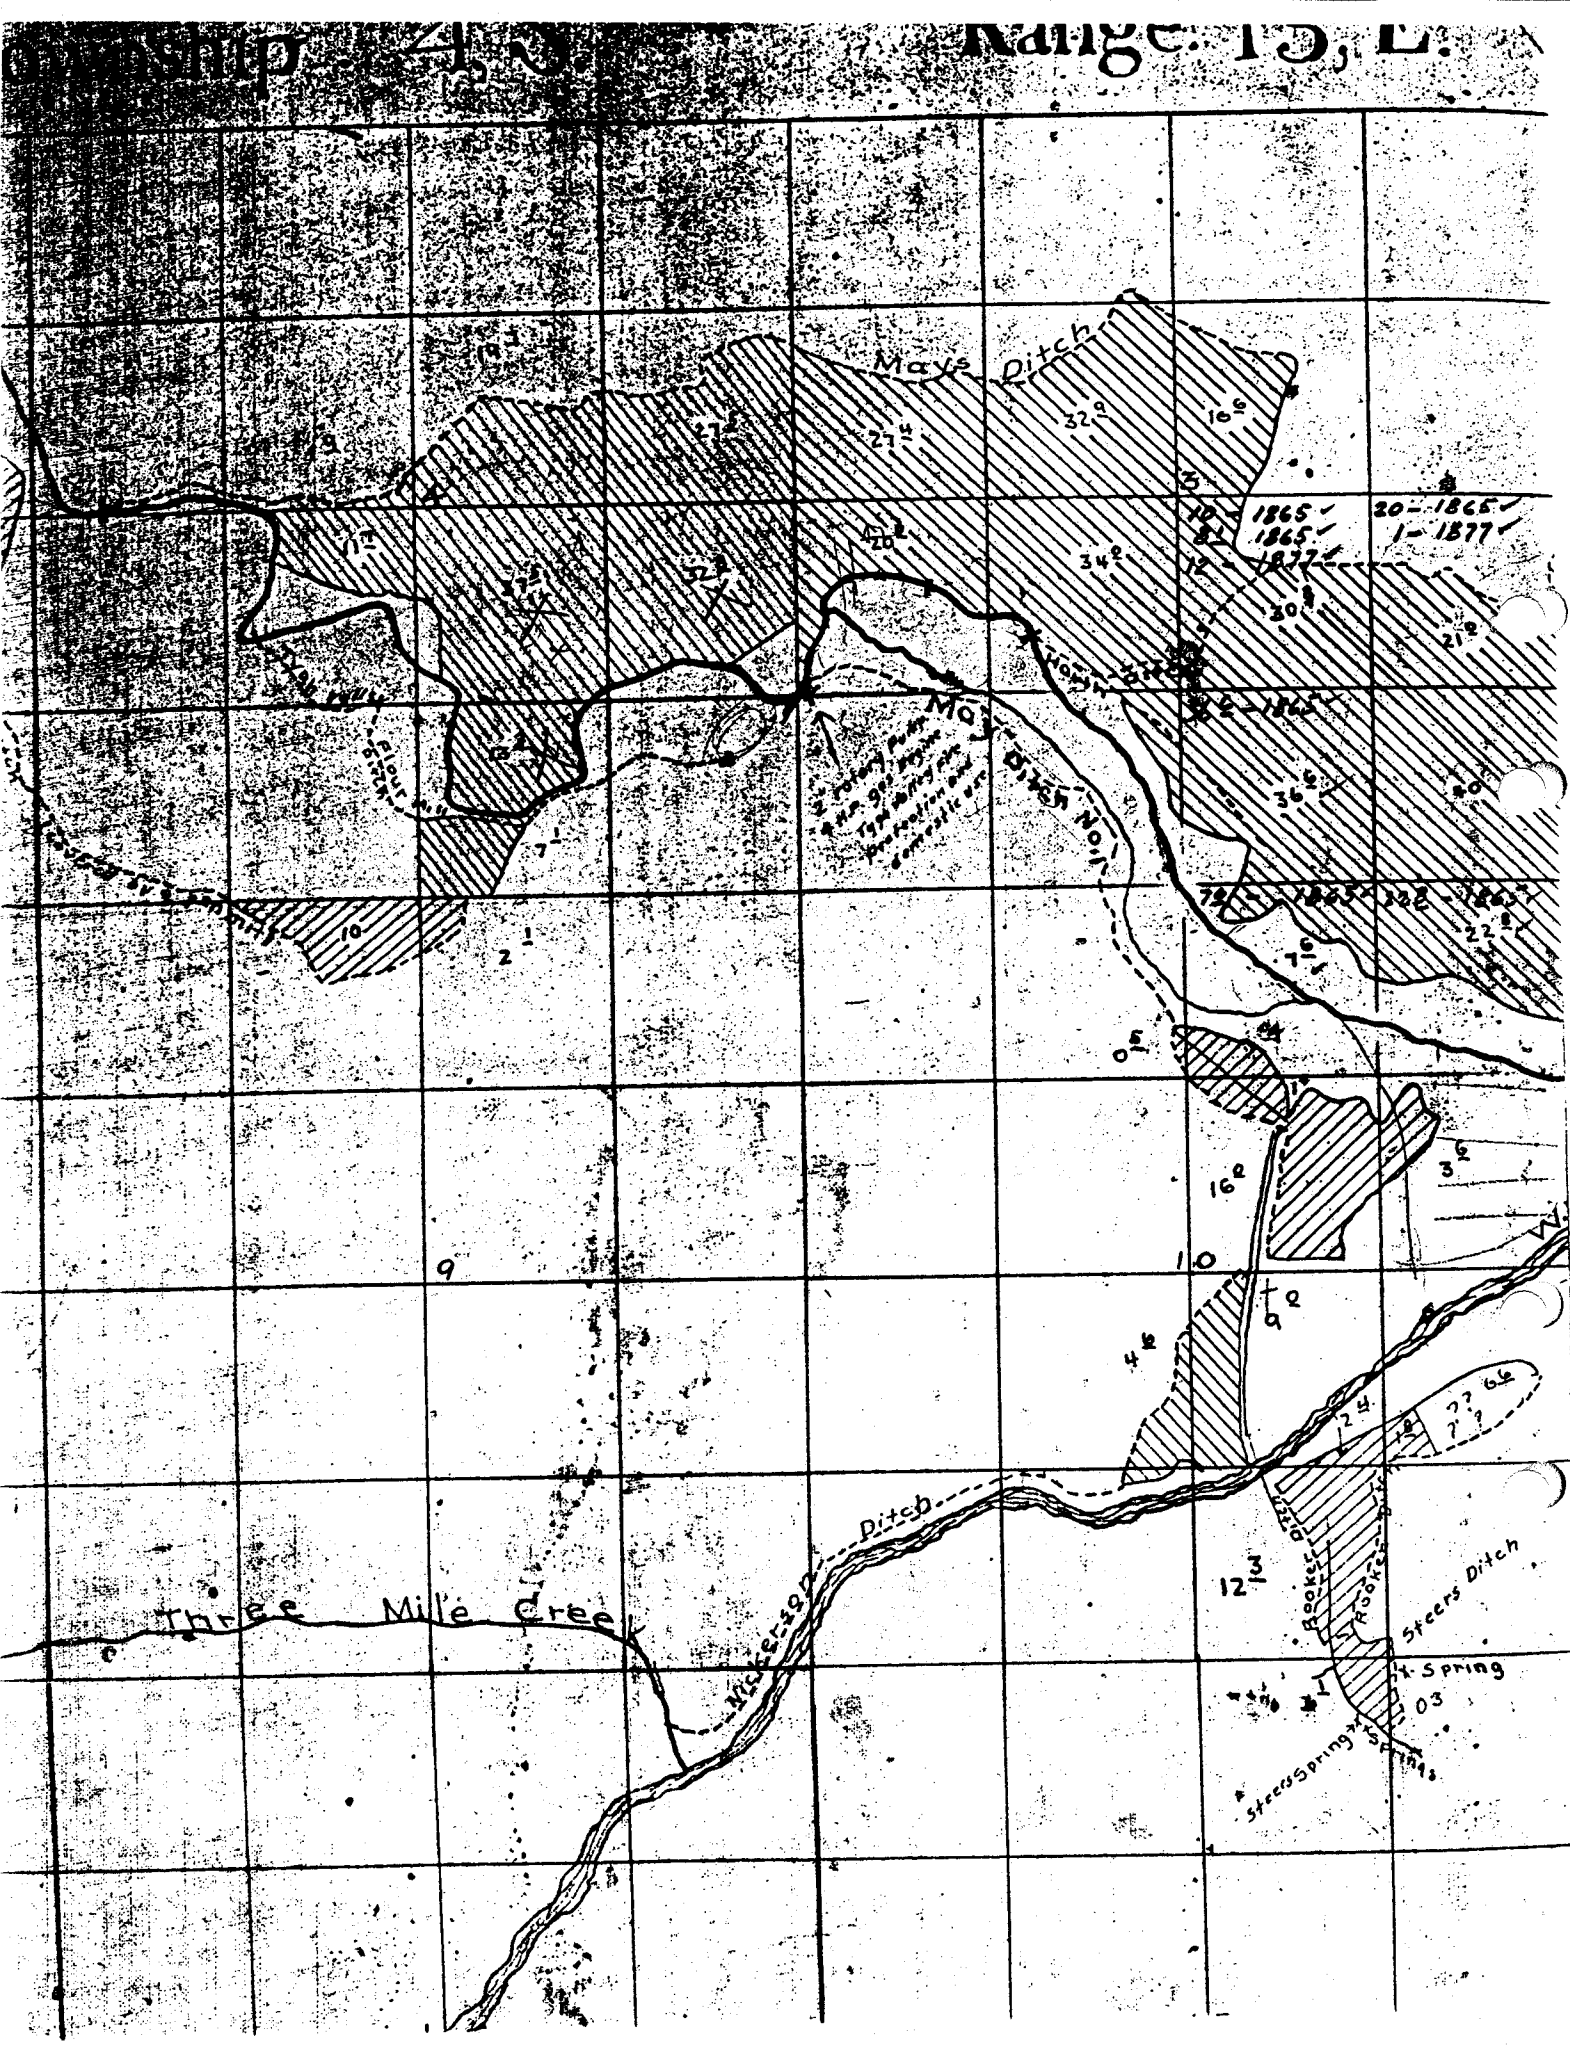

Range 15, E.
Mays Ditch
May Ditch No. 1
Three Mile Creek
Nickerson Ditch
Steers Ditch
Spring
Steers Spring