


T.3S.R.4W.W.M.

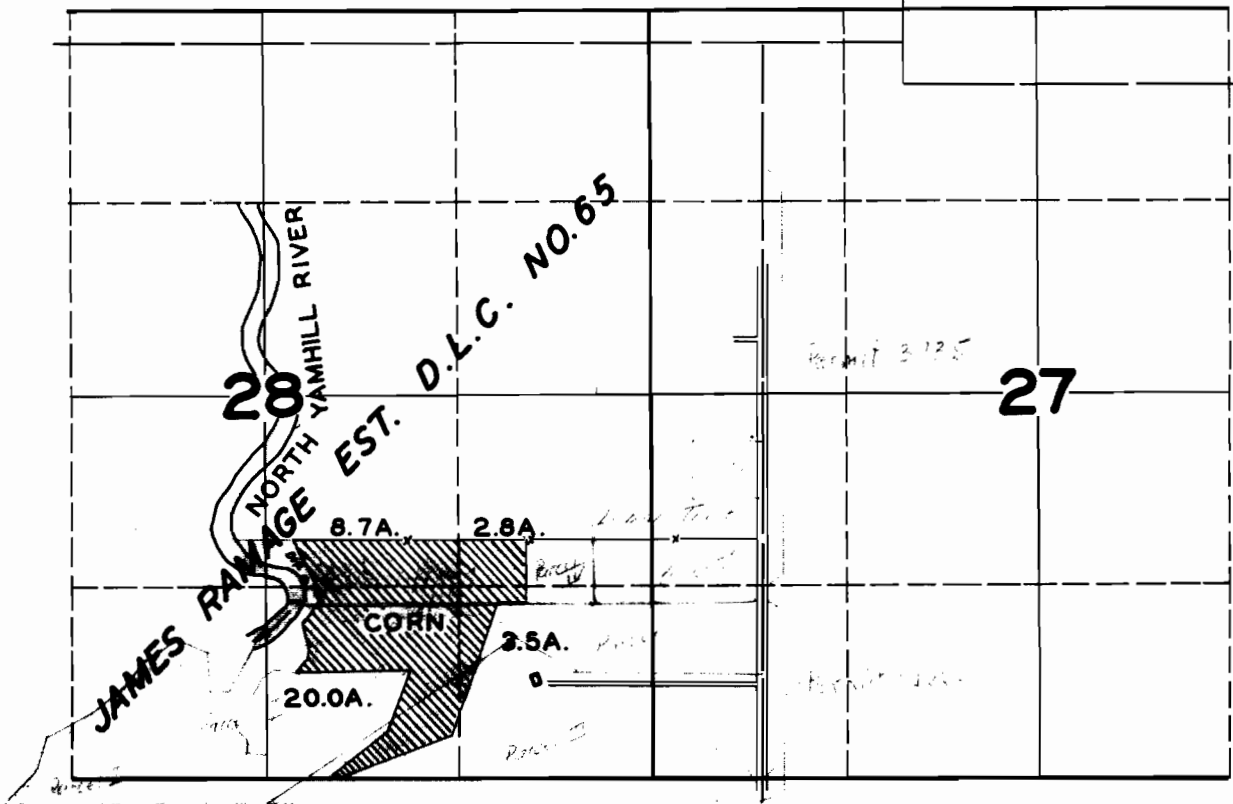

FINAL PROOF SURVEY

UNDER

18069

13735

Application No. 19302 Permit No. 14888

IN NAME OF

DR. VICTOR E. JOHNSON

Surveyed SEP. 20. 1947., by JAS. E. BUNNELL