


T.40S. R.13W., W.M.

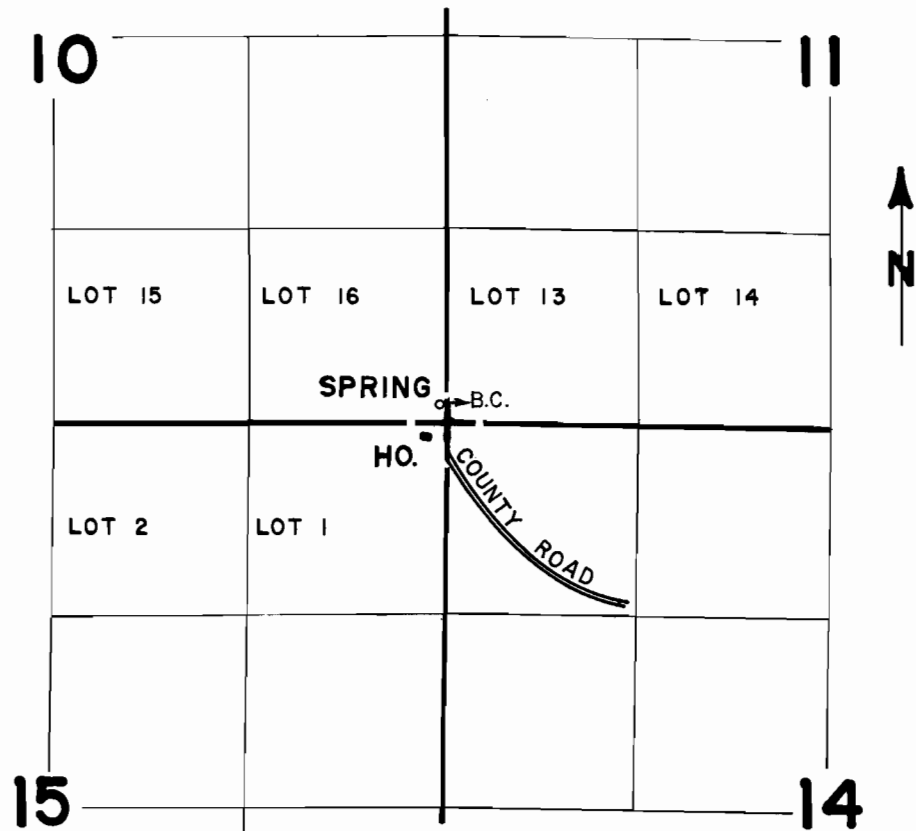

SPRING LOCATED 130' N. & 50' W. OF NW. COR. SEC. 14.

SCALE: 4" = 1 MILE

FINAL PROOF SURVEY
UNDER

Application No. 61575 Permit No. 45872
IN NAME OF

JEROME N. & RUTH D. ADLER

Surveyed OCT. 9 1985, by J. M. SCHMORDE