


T.7S. R.2W. W.M.

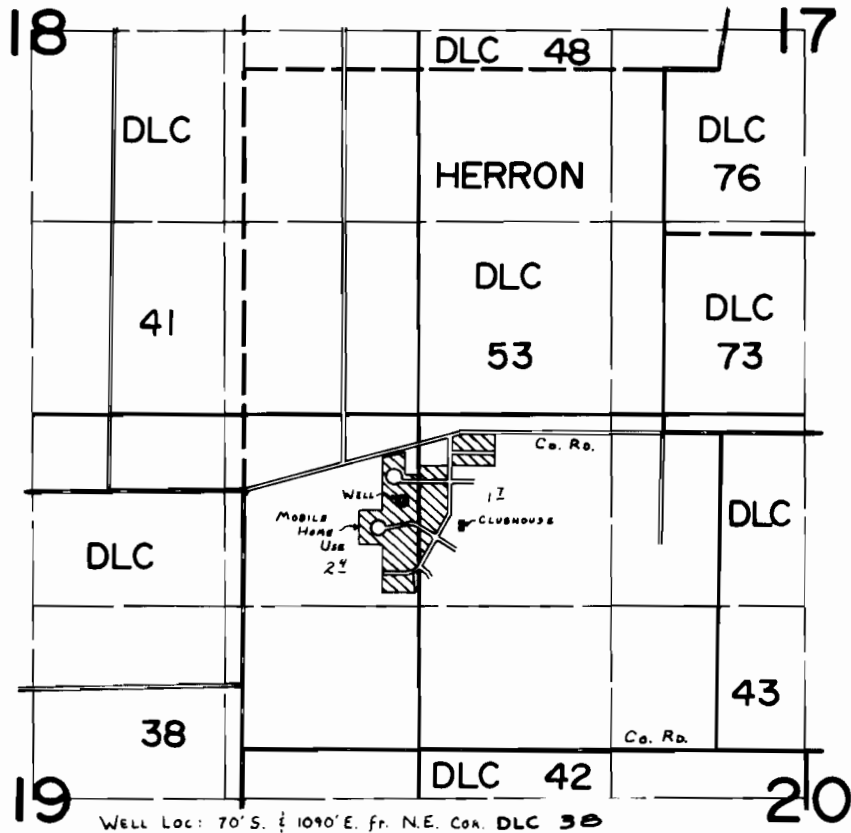

FINAL PROOF SURVEY

UNDER

Application No. **G-5031** Permit No. **G-4778**
 IN NAME OF

SLEEPY HOLLOW PHASE I WATER SYSTEM

Surveyed June 25, 1980, by C.L. Hughes.....