




T. 40 S., R. 8 W., W.M.

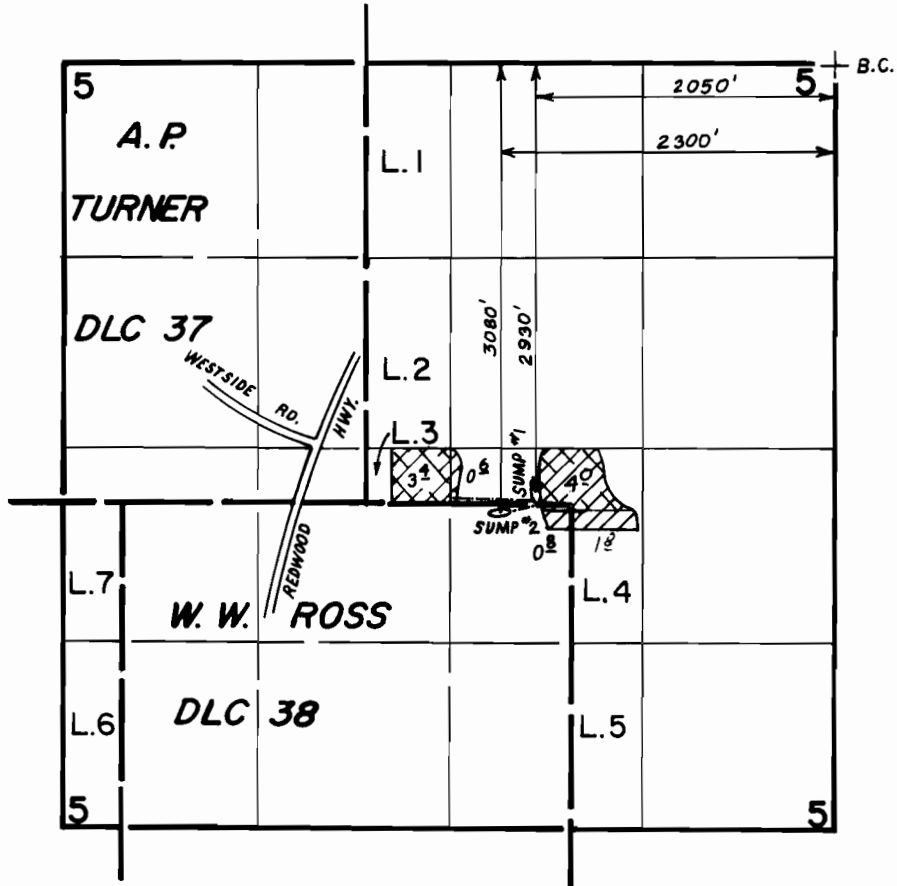

 IRRIGATION from SUMP #1

 SUPPLEMENTAL IRRIGATION

FINAL PROOF SURVEY UNDER

Application No. **G-6822** Permit No. **G-6322**
IN NAME OF

DAVID GILMORE

Surveyed **MAR. 27 1984**, by **B. S. JAMES**