


T.I.N.R.3W.W.M.

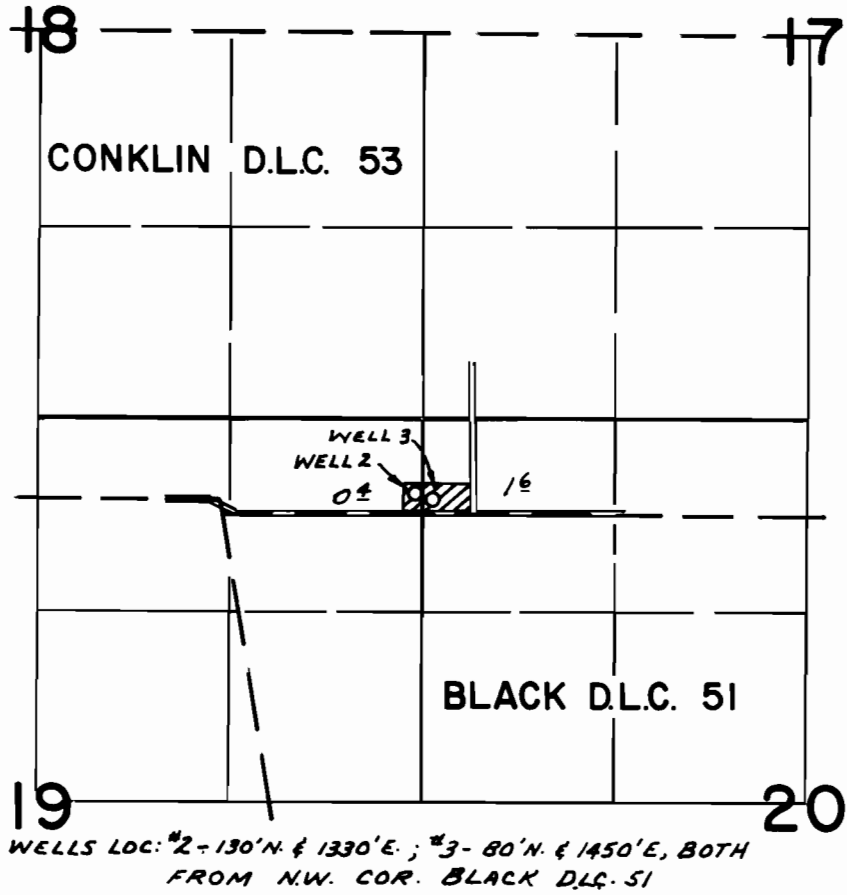

FINAL PROOF SURVEY UNDER

Application No. *G-7064* Permit No. *G-6543*
IN NAME OF

.....*FARM CREDIT SERVICES*.....

Surveyed *MAY 1, 1979*, by *R.G. MUCKEN*