

23

75 11 24

1-1918

8-1918


21-1918

20-1918

26

25

EEK

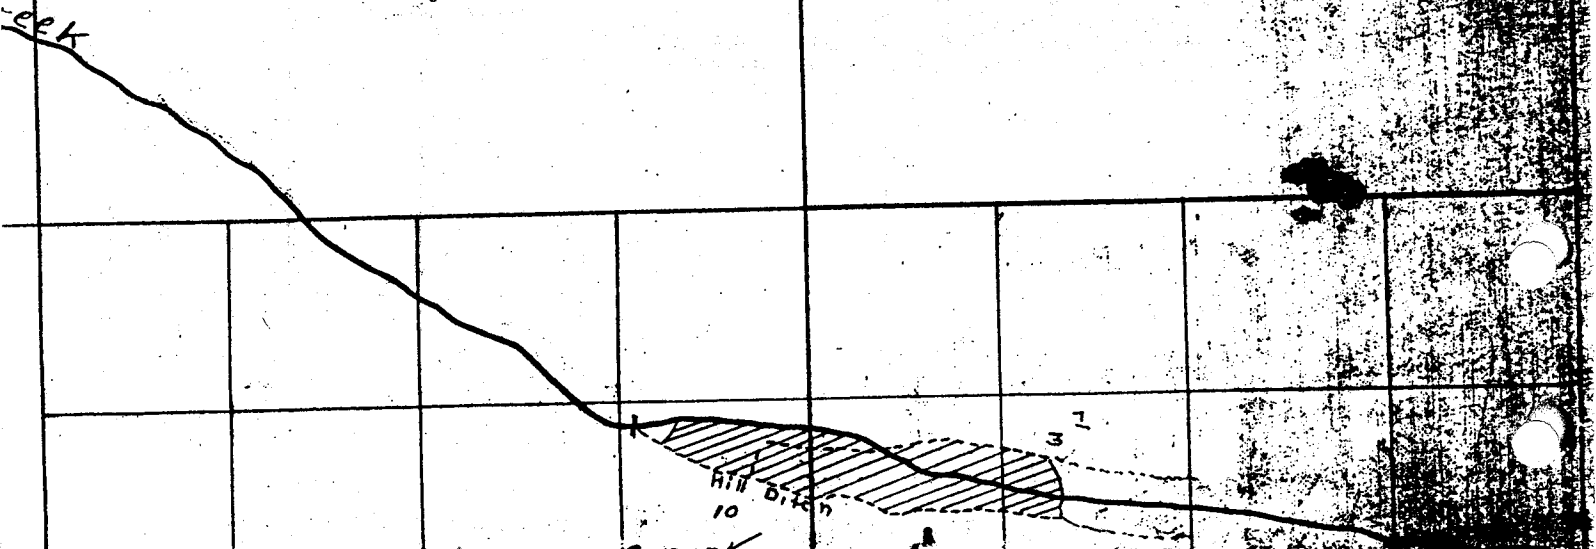

35

8-1902
2-1883

15
15-1912

10-1912 36

2-1911-Traf
5-1911-Traf
7-5-1958