
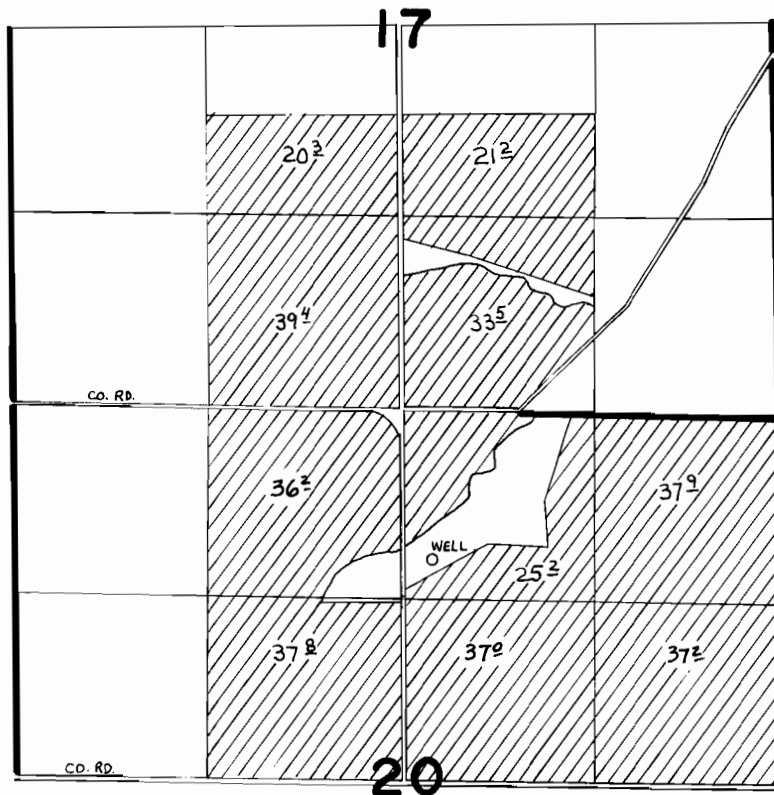


T. 2 N. R. 18 E. W.M.

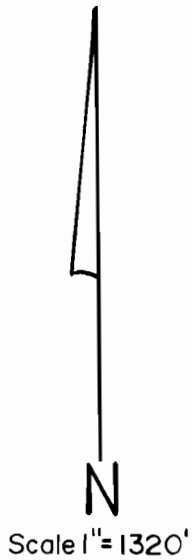

WELL LOC. 1040' S. & 200' E. FROM N. 1/4 COR. SEC. 20

FINAL PROOF SURVEY UNDER

Application No. G.7276. Permit No. G.6710.....
IN NAME OF

.....**ROBERT E. SCHARF**.....

Surveyed May 13.... 1986., by V. Church.....