


G6922  
57622

# T. 2N., R. 34E., W. M.

## SE1/4 NE1/4, SECTION 1

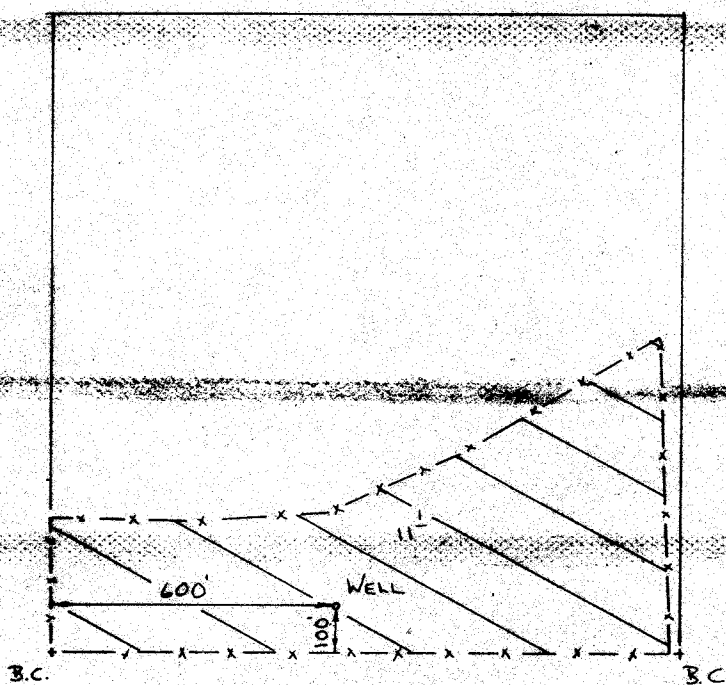

### FINAL PROOF SURVEY UNDER

Application No. **G:7419** Permit No. **G:6922**  
IN NAME OF

**THOMAS W.R. SMITH**

Surveyed 3-22 1988, by J.L. Church