


T.10S., R.3W., W.M.

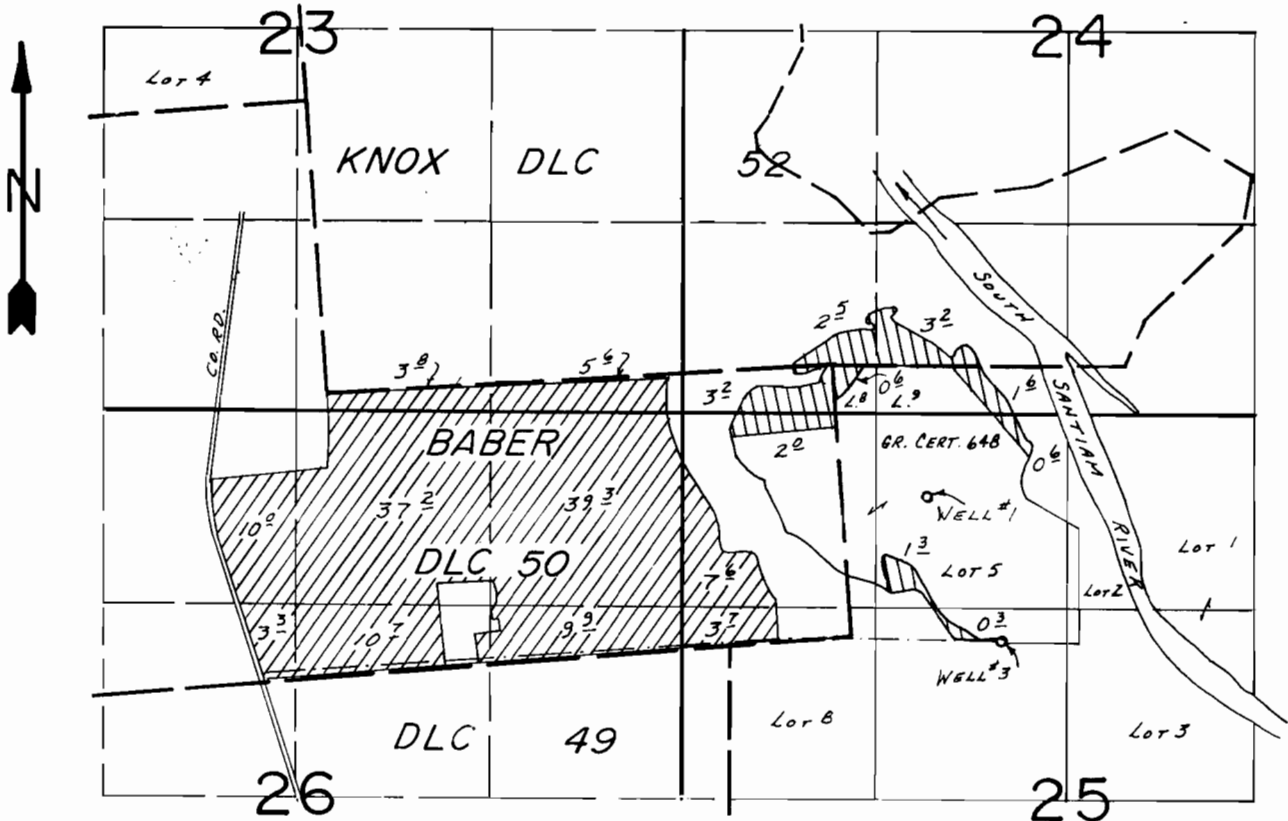

WELLS LOC.: #1-980' N & 510' E; #3-20' S & 1050' E, BOTH FROM SE COR. BABER DLC 50.

SCALE: 1" = 1320'

FINAL PROOF SURVEY

UNDER

Application No. G-8120 G-7497 
 G-9033 Permit No. G-8442... 
 IN NAME OF

.....WILMER STECKLEY.....

Surveyed Art. 27.... 19.84., by L.M.TOLL.....