


G 7824
57624

T. 4N. R. 28E. W. M.

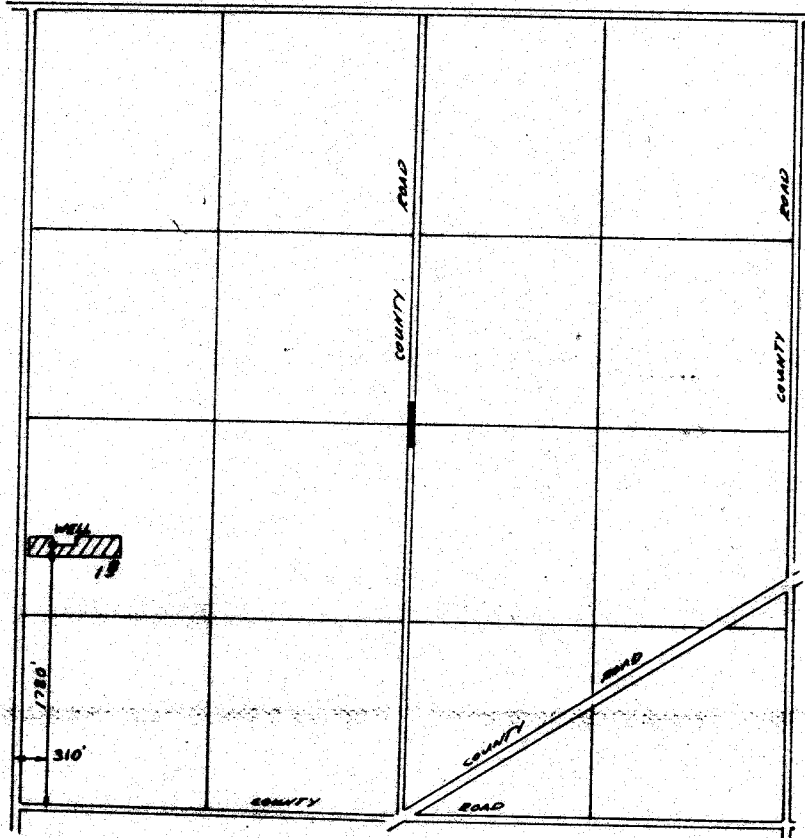

FINAL PROOF SURVEY
UNDER

Application No. G-8229 Permit No. G-7824
IN NAME OF

ROGER BYRANT

Surveyed 2-4 1978, by J. Church