


T.38S. R.4&5W. W.M.

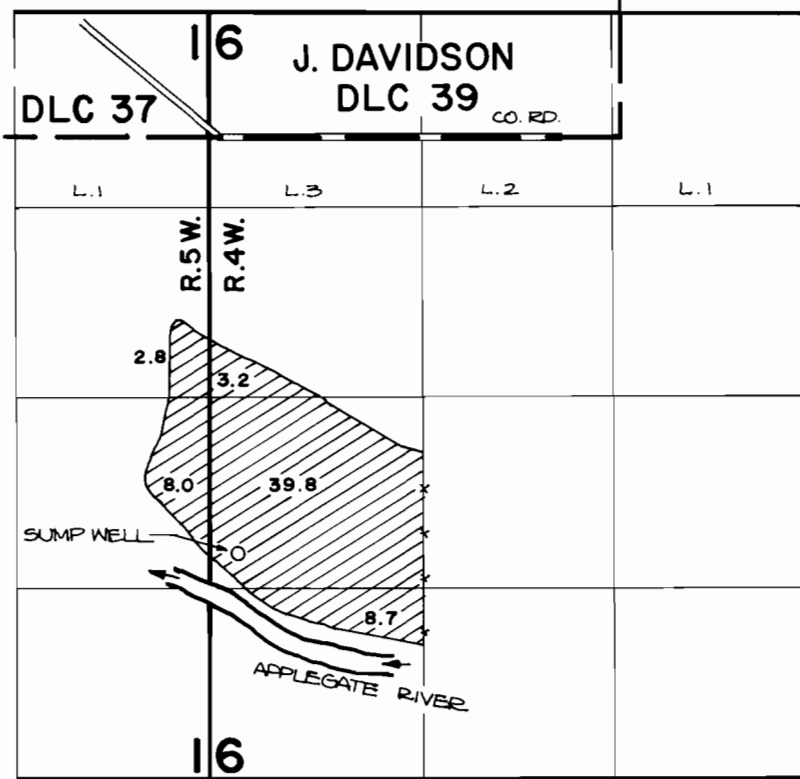

SUMP WELL IS LOCATED 1460' N. AND 200' E. FROM THE S.W. CORNER OF SECTION 16.

FINAL PROOF SURVEY
UNDER

Application No. **G-8685** Permit No. **G-8163**
IN NAME OF

GLENN SMITH

Surveyed **JULY 26 1983**, by **B. JAMES**