


T.7S.,R.2W.,W.M.

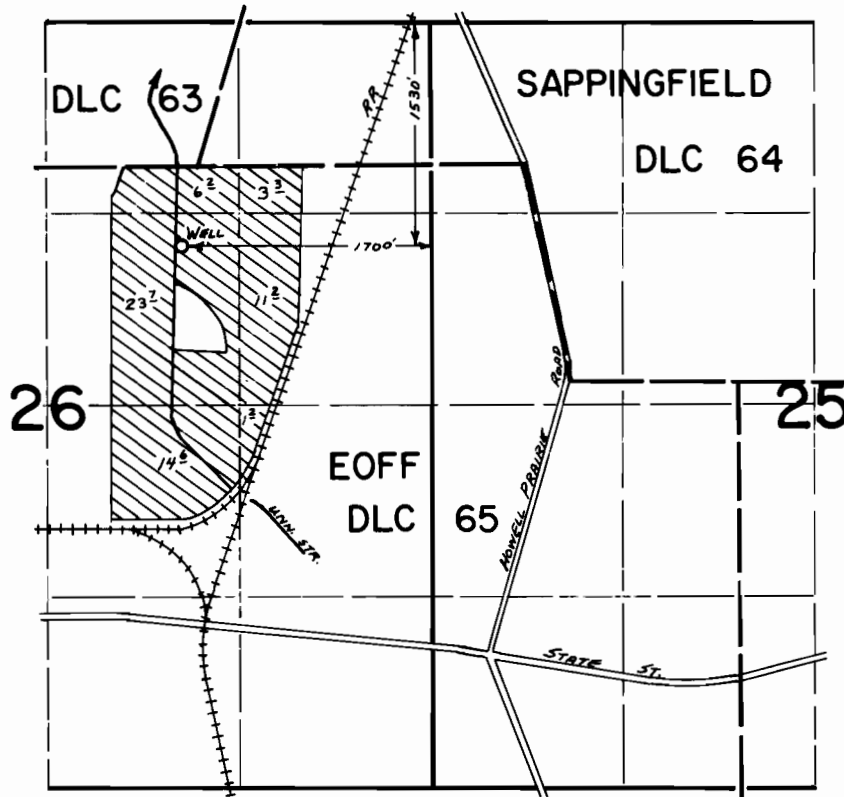

FINAL PROOF SURVEY UNDER

Application No. G:9807. Permit No. G:9042.....
IN NAME OF

.....GARY L. KAUFMAN.....

Surveyed Oct. 29. 1981., by S.G. BROWN.....