


T.7S.,R.2W.,W.M.

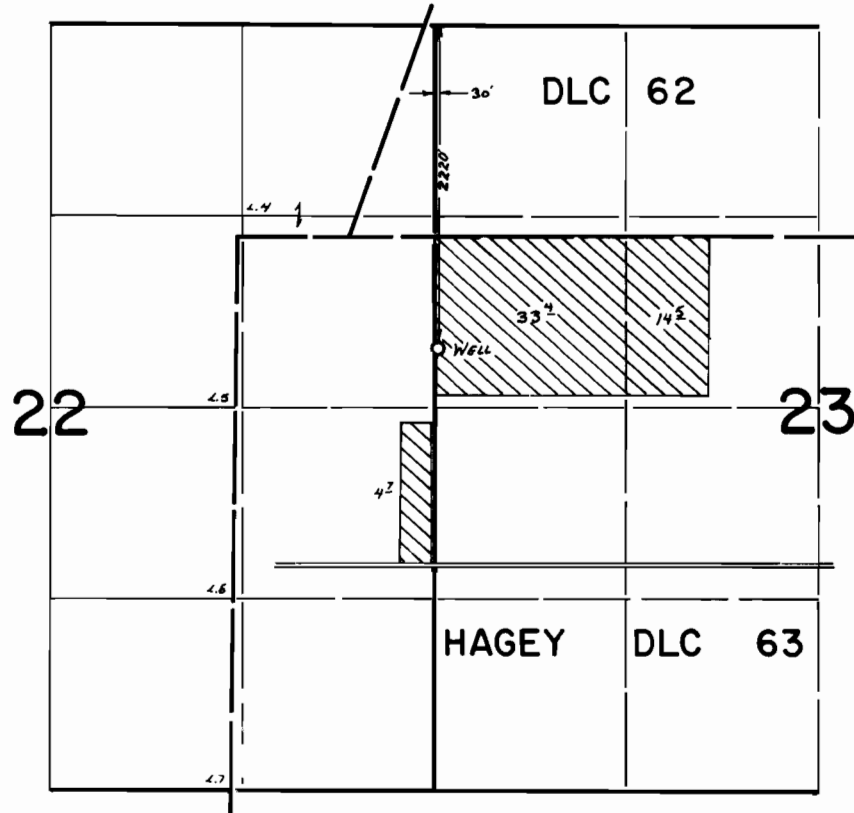

FINAL PROOF SURVEY
UNDER

Application No. G-10016. Permit No. G-9250.....
IN NAME OF

MICHAEL E. GERIG

Surveyed Oct. 28, 1981, by S. C. BROWN.....